

SFOBB Seismic Retrofit (Contract No. 04-01731)

The as-built drawings, which are contained in these CDs, are scanned from drawings of the existing structure for the convenience of the contractor and as a means to convey to the contractor the available information regarding the existing structure. It is to be understood that no claim is being made as to the accuracy or completeness of the said information and that the State of California or its officers or agents shall not be responsible for the manner in which the contractor interprets and uses this information or for the accuracy, currency or completeness of these scanned as-built drawings. The contractor shall be responsible to obtain, at the contractor’s expense, any additional information that the contractor deems necessary for completely and accurately assessing the existing conditions of the structure. The contractor shall not be entitled to any compensation for any claim arising from inaccuracy or insufficiency of these as-built drawings or in anyway related to these drawings.

- [1. General Plan](#)
- [2. Pedestal Jacket Details E10-E22](#)
- [3. Pedestal Anchorage Details](#)
- [4. Pier E2](#)
- [5. Pier E3](#)
- [6. Pier E4](#)
- [7. Pier E5](#)
- [8. Pier E6](#)
- [9. Pier E9](#)
- [10. Pier E10](#)
- [11. Pier E17](#)
- [12. Piers E7, E8, E11, E12 and E13](#)
- [13. Piers E14, E15, E16, E18 and E19](#)
- [14. Piers E20, E21 and E22](#)
- [15. Details for Piers E-10 to E-22](#)
- [16. Details for Piers E-17 to E-22](#)

28 Day Concrete Strengths (PSI)					
Pier	Strength	Pier	Strength	Pier	Strength
10N	5620 psi	16N	6220 psi	20N	5175 (Avg)
10S	6030 (4910)	17N	5530 psi	20S	5410 psi
12S	5800 psi	18N	5295 (Avg)	21N	5115 (Avg)
13S	6280 psi	18S	5500 (Avg)	21S	5150 psi
14S	5690 psi	19N	6020 psi	22S	5590 psi

AS
CORREC. S. Whipple
CONTRACT NO. 04-001734
DATE 8/92
ML Graves 4-5-93


DIST.	COUNTY	ROUTE	POST MILES TOTAL PROJECT	SHEET NO.	TOTAL SHEETS
04	SF, Ala	80	7.8/8.8, 0.0/1.3	2	15

11-20-89
PLANS APPROVAL DATE

PROFESSIONAL ENGINEER
ROBERT WHITTEN
No. 43167
Exp. 3-31-92
CIVIL
STATE OF CALIFORNIA

ELEVATION
1" = 125'

- Notes:
- E10 to E22 Reinforced concrete jacket around existing pedestals
 - E23 to E32 Strengthen anchorages to concrete columns.

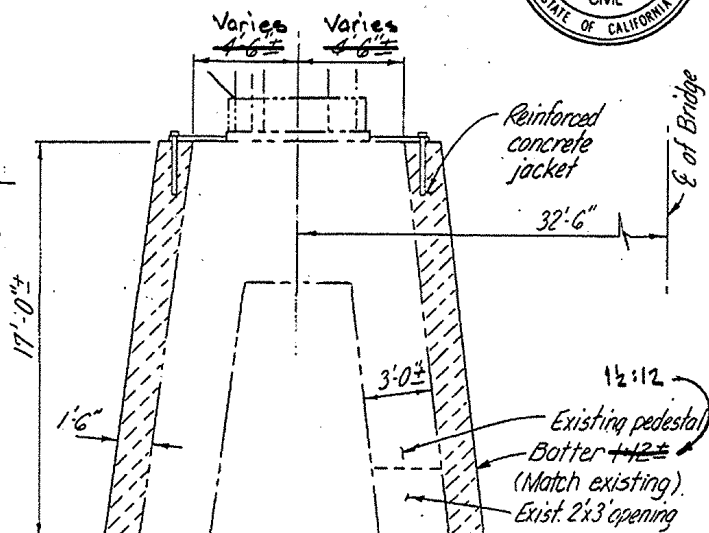


TOP DIMENSION OF PIER E11 (EXIST)
15 11'-2" x 16'-2"

TYPICAL PEDESTAL SECTION
1/4" = 1'-0"

APPROXIMATE QUANTITIES	
REPAIR UNSOUND CONCRETE SURFACE AREAS	1,200 SQFT
DRILL AND GROUT DOWEL	8,400 LF
EPOXY CRACK INJECTION	3,000 LF
SEAL CONCRETE SURFACE	146,400 SQFT

FINAL PAY QUANTITIES	
STRUCTURAL CONCRETE, BRIDGE	2,068 CY
BAR REINFORCING STEEL (EPOXY COATED)	656,100 LB
MISCELLANEOUS METAL (BRIDGE)	70,400 LB
SEAL CONCRETE SURFACE	187,400 SQFT

TOP OF PEDESTAL MODIFIED ON PIERS E17 TO E22 - SEE EXTRA SHEETS AT BACK OF PLANS

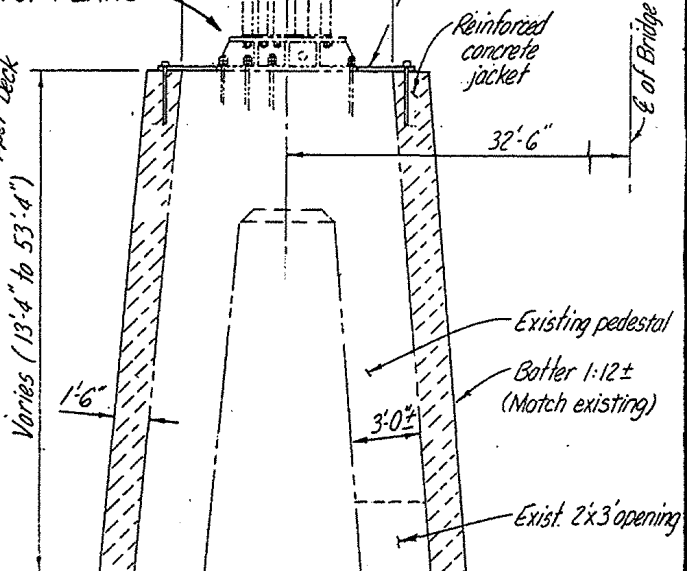

(E17 TO E22)
TYPICAL PEDESTAL SECTION
1/4" = 1'-0"

ADDED SHEETS FOR SHEAR BLOCKS AT TOP OF PEDESTALS

REVISED FOR ADDENDUM NO. 1 DATED JANUARY 22, 1990

PLAN
1" = 125'

SHEET NO.	TITLE
1	GENERAL PLAN
2	PEDESTAL JACKET DETAILS E10-E22
3	PEDESTAL ANCHORAGE DETAILS
4	PIER E2
5	PIER E3
6	PIER E4
7	PIER E5
8	PIER E6
9	PIER E9
10	PIER E10
11	PIER E17
12	PIERS E7, E8, E11, E12 AND E13
13	PIERS E14, E15, E16, E18 AND E19
14	PIERS E20, E21 AND E22
15	DETAILS FOR PIERS E10 TO E22
16	DETAILS FOR PIERS E17 TO E22

NOTE:
THE CONTRACTOR SHALL VERIFY ALL CONTROLLING FIELD DIMENSIONS BEFORE ORDERING OR FABRICATING ANY MATERIAL.

GENERAL NOTES
LOAD FACTOR DESIGN

DESIGN: BRIDGE DESIGN SPECIFICATIONS
(1983 AASHTO with Interims and Revisions by CALTRANS)

REINFORCED CONCRETE: $f'_c = 60,000$ psi
 $f'_c = 3,250$ psi
 $n = 9$

STRUCTURAL STEEL: $f_y = 36,000$ psi

Curve Data
 $R = 2000'$
 $\Delta = 10^\circ 55' 14"$
 $T = 191.18'$
 $L = 381.20'$

04001734
16 pages

Submitted by: R. O. G. 2/89	DESIGN: By: R. Nakada 9/88	Checked: S. Chouhary	LOAD FACTOR DESIGN	LIVE LOADING: HS20-44 AND ALTERNATIVE... AND PERMIT DESIGN LOAD	State of CALIFORNIA	DIVISION OF STRUCTURES	BRIDGE NO. 33-25	S.F.O.B.B. SEISMIC RETROFIT
DESIGN ENGINEER: R. O. G. 2/89	DETAILS: By: R. Nakada 9/88	Checked: S. Chouhary	LAYOUT	By: S. Chouhary	DEPARTMENT OF TRANSPORTATION	STRUCTURE DESIGN 4	POST MILE 0.0/1.3	GENERAL PLAN
DESIGN ENGINEER: R. O. G. 2/89	QUANTITIES: By: R. Nakada 9/88	Checked: S. Chouhary	SPECIFICATIONS	By: S. Chouhary	PROJECT ENGINEER: R. O. G. 2/89	REGISTERED CIVIL ENGINEER NO. 43167	REVISION DATES (PRELIMINARY STAGE ONLY)	SHEET 2 OF 15


ORIGINAL SCALE IN INCHES FOR REDUCED PLANS

CU 04333
EA 001731

Disregard prints bearing earlier revision dates


REVISION DATES (PRELIMINARY STAGE ONLY)

7/1/88 5/1/89

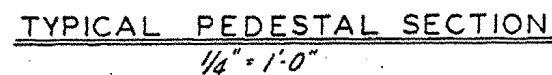

DETAIL - A
No Scale

PIER	HT.(H)	BASE		TOP
E17	53'-4"	17'-10 1/2"	20'-10 1/2"	9'-0" x 12'-0" ±
E18	45'-4"	16'-6 1/2"	19'-6 1/2"	↓
E19	37'-4"	15'-2 1/2"	18'-2 1/2"	
E20	29'-4"	13'-10 1/2"	16'-10 1/2"	
E21	21'-4"	12'-6 1/2"	15'-6 1/2"	
E22	13'-4"	11'-2 1/2"	14'-2 1/2"	
E10 - E16	17'-0"	11'-10"	14'-10"	
E11	17'-0"	15'-4"	20'-4"	11'-2" x 16'-2"
E12 - E16	17'-0"	13'-3"	16'-3"	9'-0" x 12'-0" ±
E10	17'-0"	13'-3"	16'-3"	9'-0" x 12'-0" ±

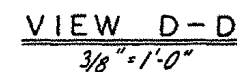

Notes:


1. All reinforcing steel to be epoxy coated.
2. Apply concrete sealant to all concrete surfaces of the reinforced concrete jacket including the top of the existing pedestal.

DESIGN	By Robert O. K. to 14/83	Checked N. Chouhary
DETAILS	By Ralph Nakooka 10/188	Checked R. O. K. to 14/83
QUANTITIES	By 1/1/84	Checked m. i. l.

DIVISION OF STRUCTURES
STRUCTURE DESIGN
Robert J. O'Brien 4/31/67



BRIDGE NO.	33-25
POST MILE	0.0 / 1.3

S.F.O.B.B. SEISMIC RETROFIT
PEDESTAL JACKET DETAILS-E10-E22

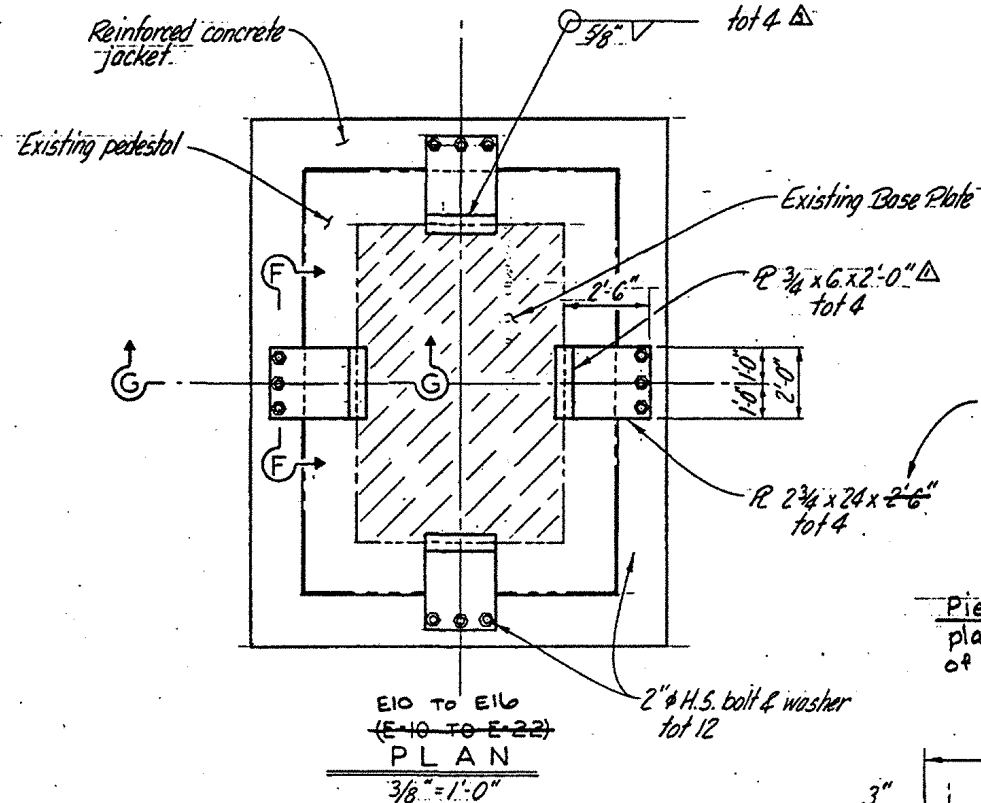

LENGTH OF PLATE VARIES TO FIT EACH DIMENSION, PER PEDESTAL, PER SIDE.


Piers E17 TO E22 - New 2 3/4" plate extends to inside face of new shear block only.

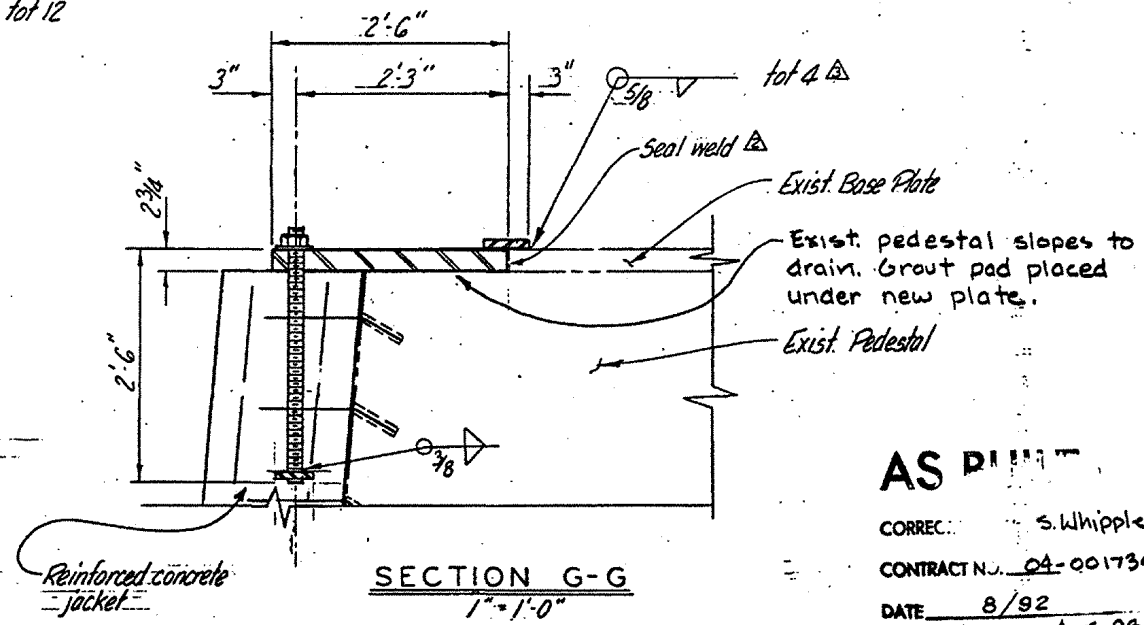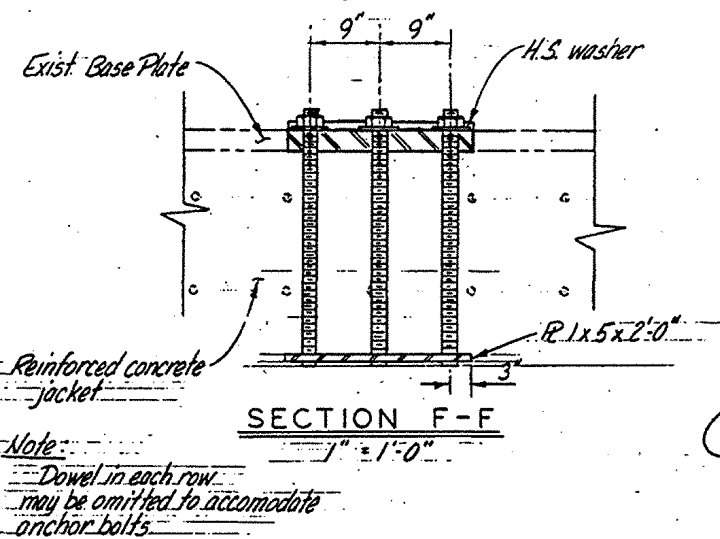


AS PER
CORRECTED BY S. Whipple
CONTRACT NO. 04-001734
DATE 8/92
MLB:graves 4-5-93

MARK	DATE	DESCRIPTION	BY	CHKD
Δ	1-5-89	change plate size	EW	NC
Δ	1-5-89	place seal weld	EW	NC
Δ	1-5-89	change weld type	EW	NC
MARK	DATE	DESCRIPTION	BY	CHKD
REVISIONS				



NOTE:
THE CONTRACTOR SHALL VERIFY ALL CONTROLLING FIELD DIMENSIONS BEFORE ORDERING OR FABRICATING ANY MATERIAL.

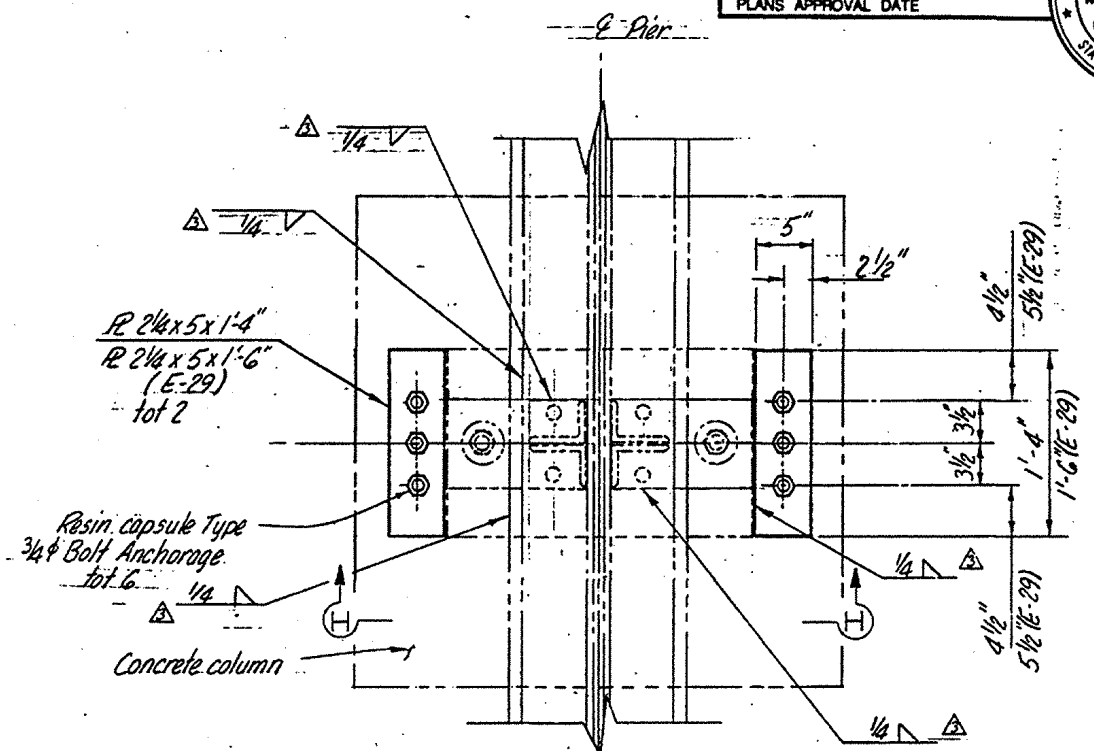

Note: Resin capsule anchorage is subject to approval of Engineer. Installation procedure shall comply with manufacturer instructions.

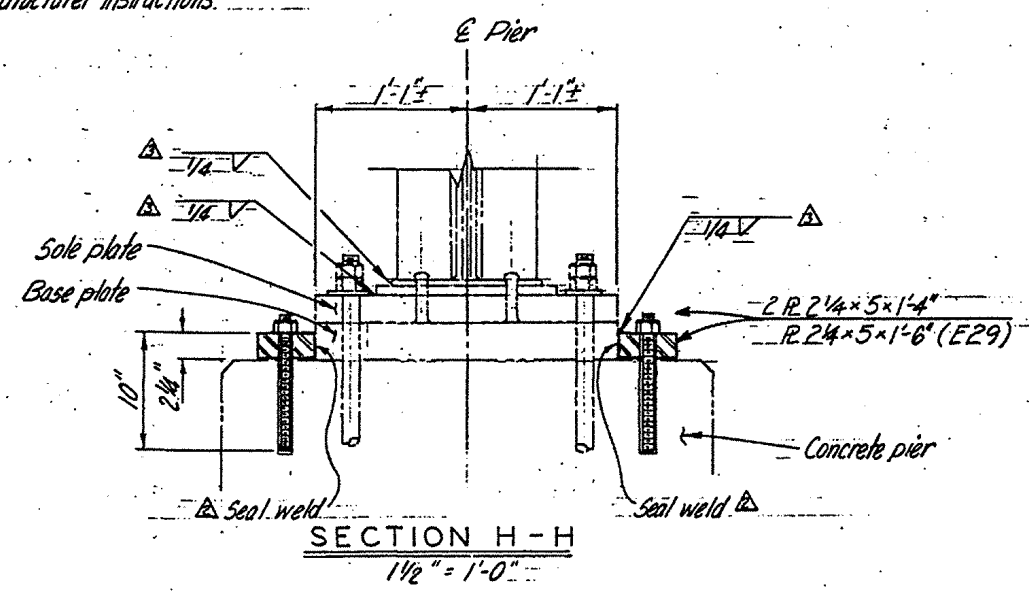


1/ REVISOR FOR ADDENDUM NO. 1 DATED JANUARY 22, 1990

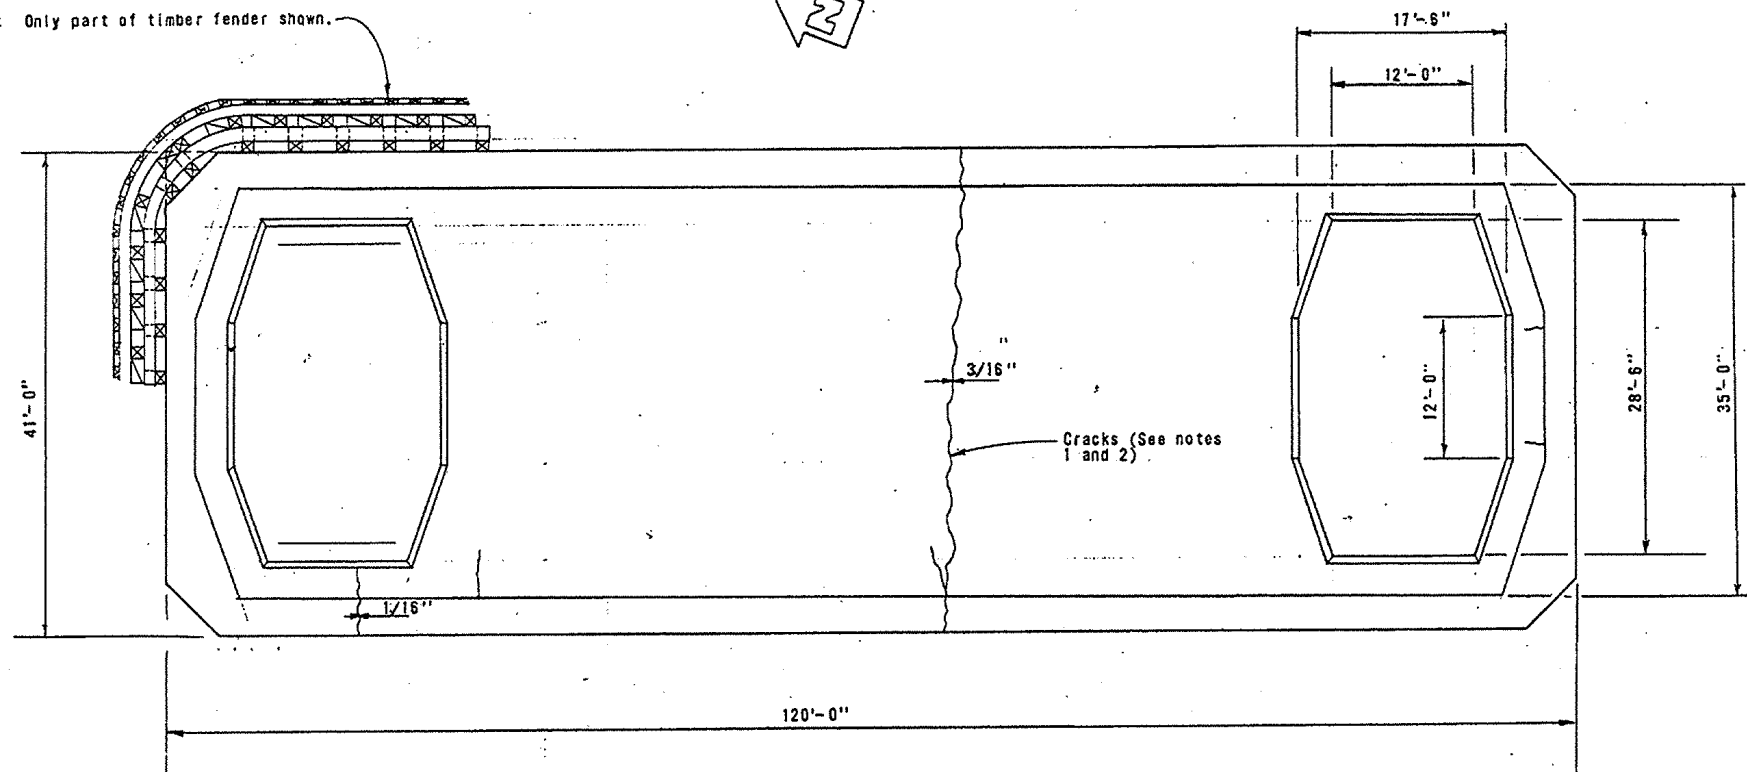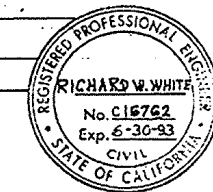

PLAN
No Scale

ACTUAL CRACK SEALING VARIES

Note: Steel superstructure not shown

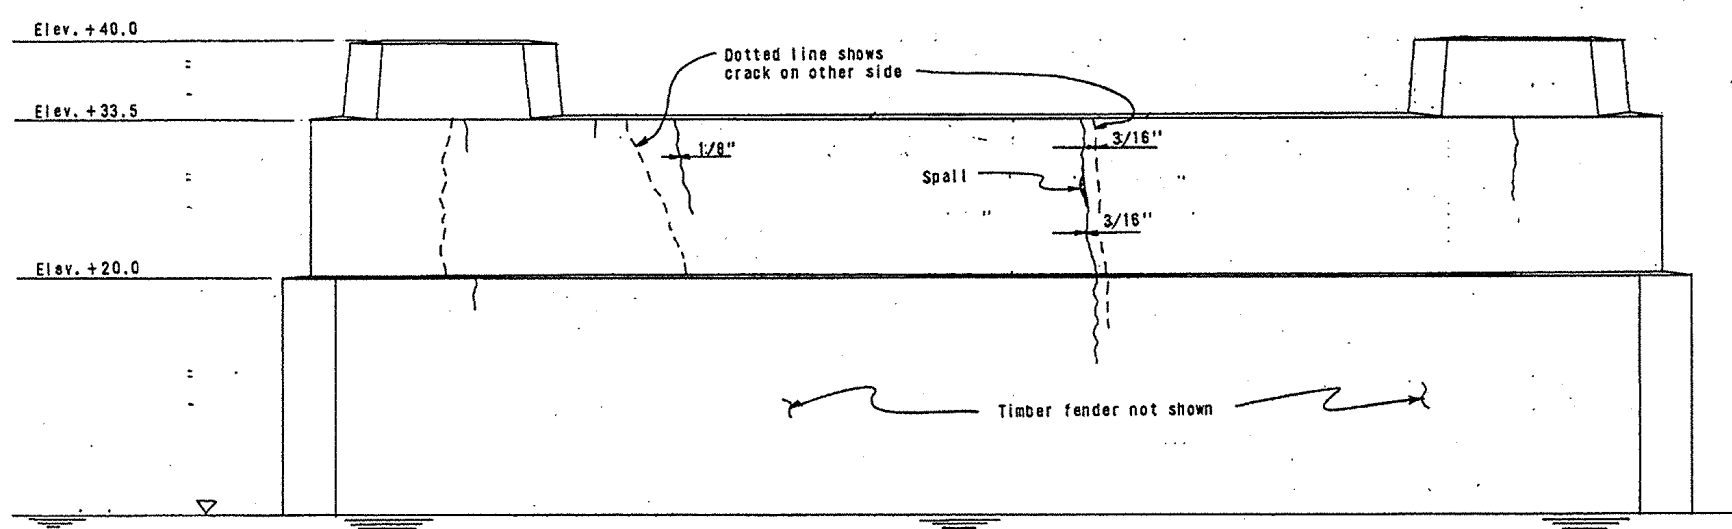


ELEVATION
No Scale

NOTES


1. Inject cracks where shown in plan and elevation views. Crack widths shown are approximate. Undimensioned cracks are less than 1/16" in width.
2. The locations of the cracks are taken from field inspection notes and may vary from that shown. The exact locations will be determined by the Engineer in the field.
3. Apply concrete sealant to all concrete surfaces between Elev. +20.0 and Elev. +40.0, including the tops of the pedestals.

Note: Elevations shown are based on S.F.O.B.B. M.L.L.W. Datum.

AS
CORRECTED S. WHIPPLE
CONTRACT NO. 04-001734
DATE 8/92 FRS 4/8/94

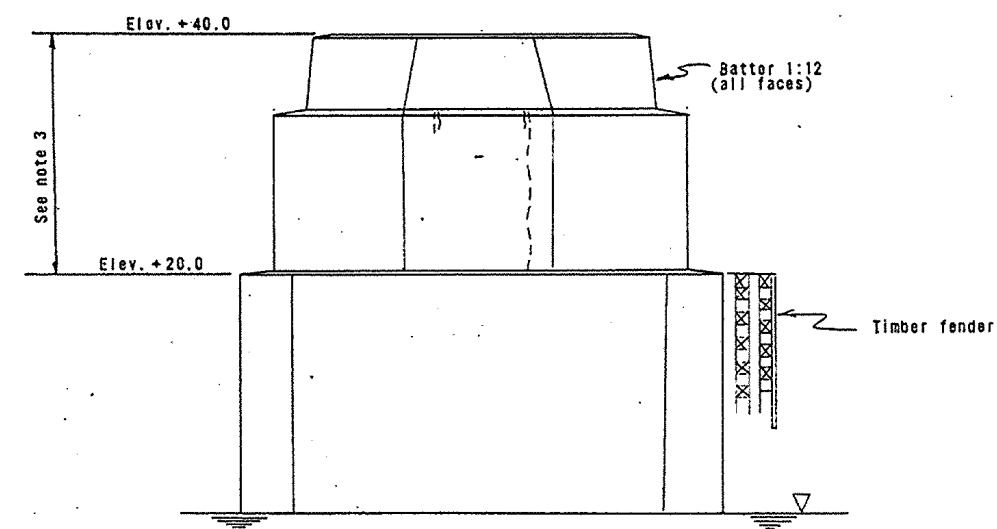

END ELEVATION
No Scale

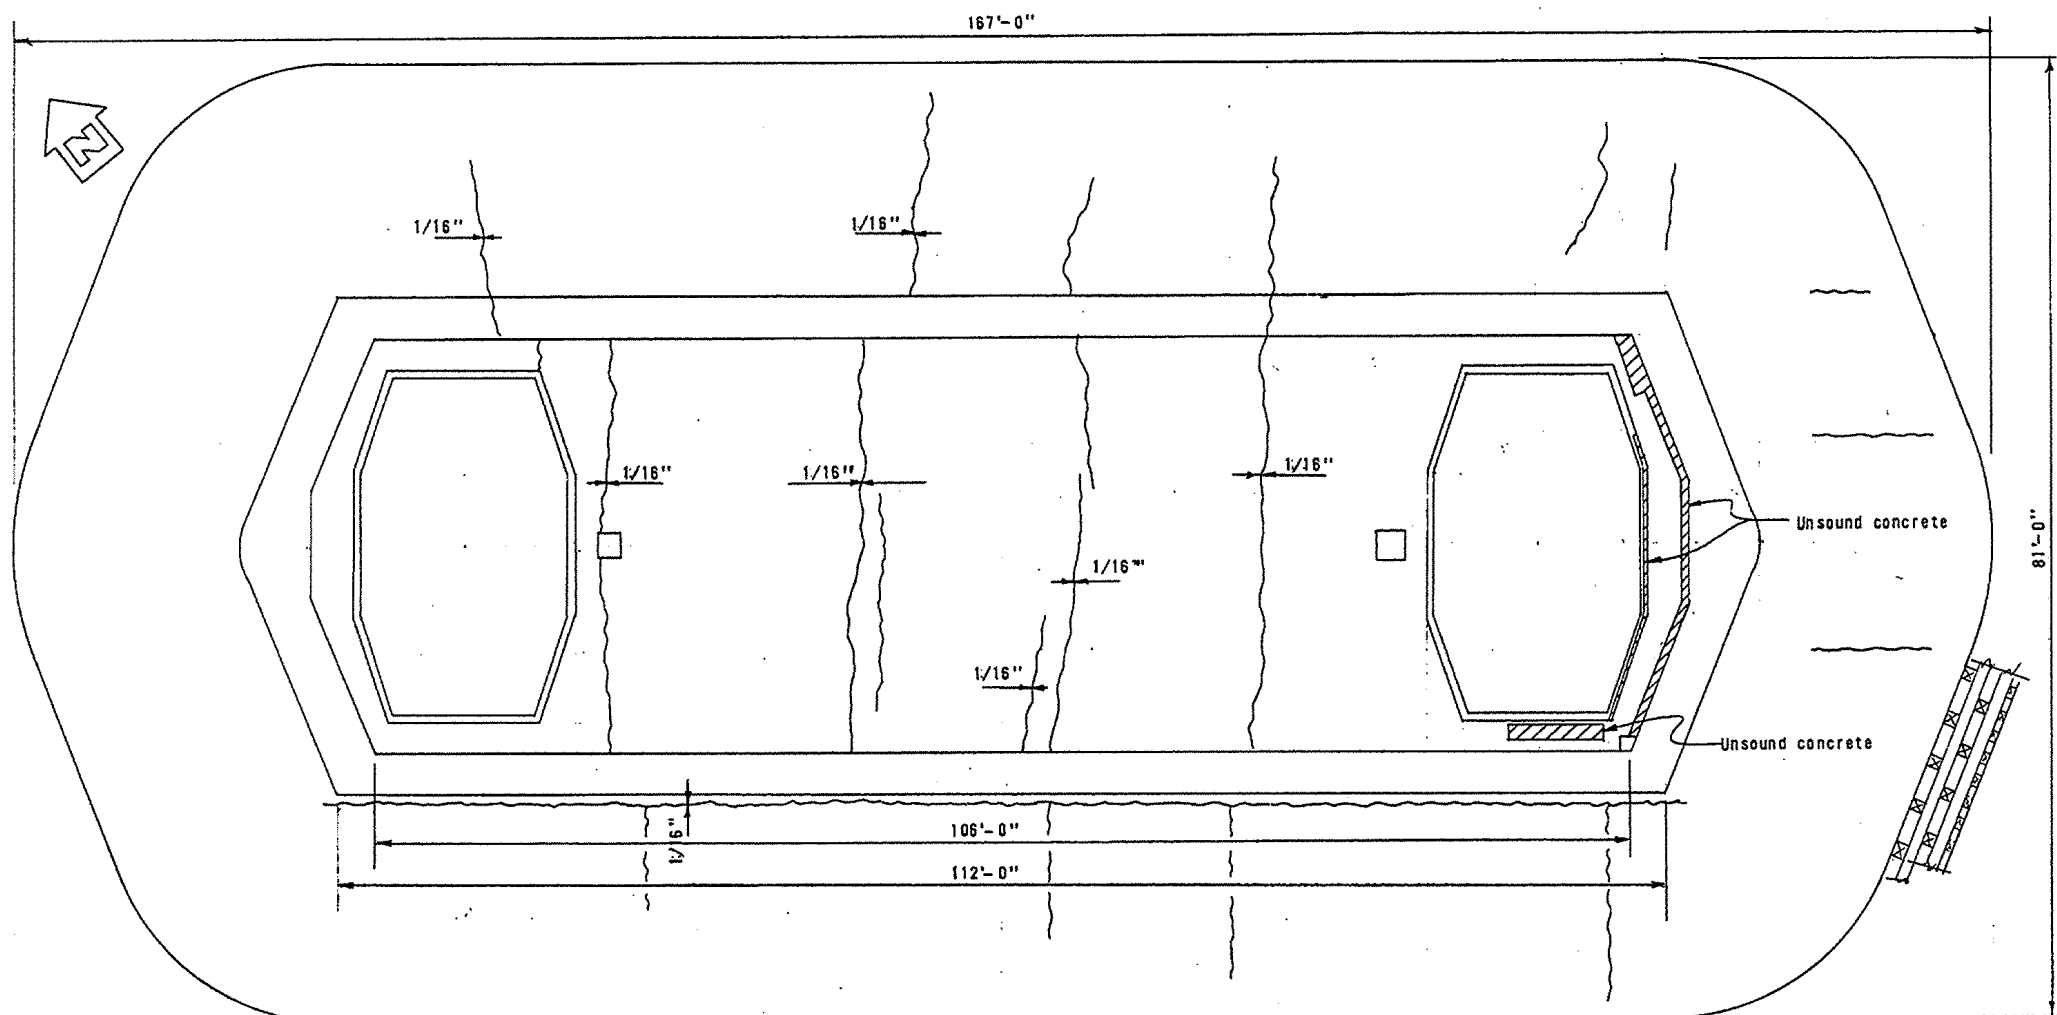

DIST.	COUNTY	ROUTE	POST MILE-TOTAL PROJECT	SHEET NO.	TOTAL SHEETS
04	SF, Ala	80	7.8/8.8, 0.0/1.3	6	15


REGISTERED ENGINEER - CIVIL
 11-20-89
 PLANS APPROVAL DATE

REGISTERED PROFESSIONAL ENGINEER
 RICHARD W. WHITE
 No. C16762
 Exp. 6-30-93
 CIVIL
 STATE OF CALIFORNIA

NOTES

1. Inject cracks where shown in plan and elevation views. Crack widths shown are approximate. Undimensioned cracks are less than 1/16" in width.
2. The locations of the cracks are taken from field inspection notes and may vary from that shown. The exact locations will be determined by the Engineer in the field.
3. Apply concrete sealant to all concrete surfaces between Elev. +20.0 and Elev. +40.0, including the tops of the pedestals.

Note: Elevations shown are based on S.F.O.B.B. M.L.L.W. Datum.

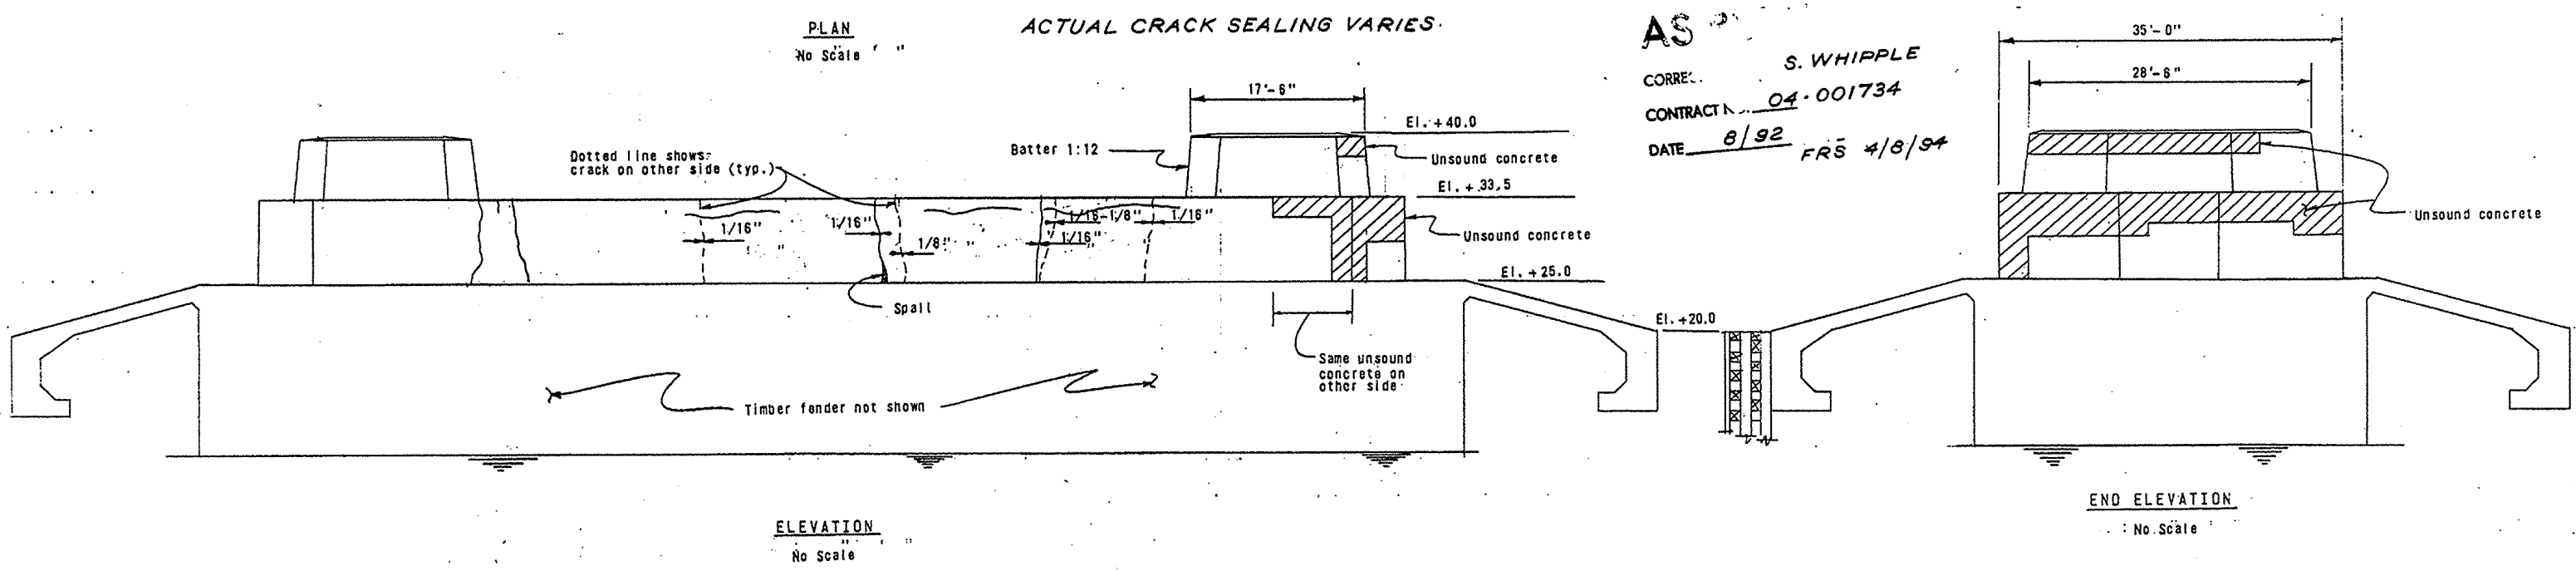

AS
 CORRECTED
 S. WHIPPLE
 CONTRACT NO. 04-001734
 DATE 8/92 FR 5 4/8/94

ELEVATION
 No Scale

END ELEVATION
 No Scale

DESIGN	By R. White	Checked S. Larson
DETAILS	By D. Wu	Checked R. White
QUANTITIES	By W. Toy	Checked

State of CALIFORNIA
 DEPARTMENT OF TRANSPORTATION

STRUCTURES MAINT.
 Richard W. White C16762
 PROJECT ENGINEER REGISTERED CIVIL ENGINEER NO.

BRIDGE NO. 33-25
 POST MILE 00/13

SAN FRANCISCO - OAKLAND BAY BRIDGE
SEISMIC RETROFIT
 PIER E3

ORIGINAL SCALE IN INCHES FOR REDUCED PLANS

CU 04 333
 WO 001731




Discard prints bearing earlier revision dates

REVISION DATES (PRELIMINARY STAGE ONLY)

DIST.	COUNTY	ROUTE	POST MILES—TOTAL PROJECT	DAILY MILES	TOTAL DAYS
04	SF, Alameda	80	7.8/8.8, 0.0/1.3	7	15

R. W. White
 REGISTERED ENGINEER—CIVIL
 11-20-89
 PLANS APPROVAL DATE

REGISTERED PROFESSIONAL ENGINEER
 RICHARD W. WHITE
 No. C16762
 Exp. 6-30-93
 CIVIL
 STATE OF CALIFORNIA

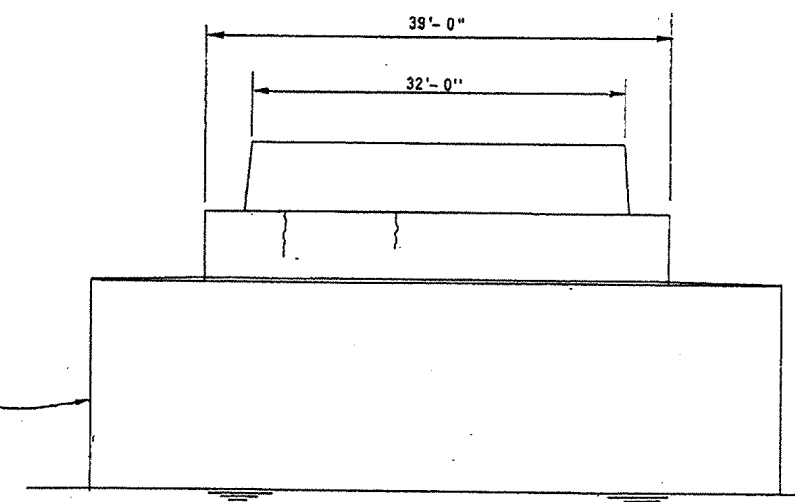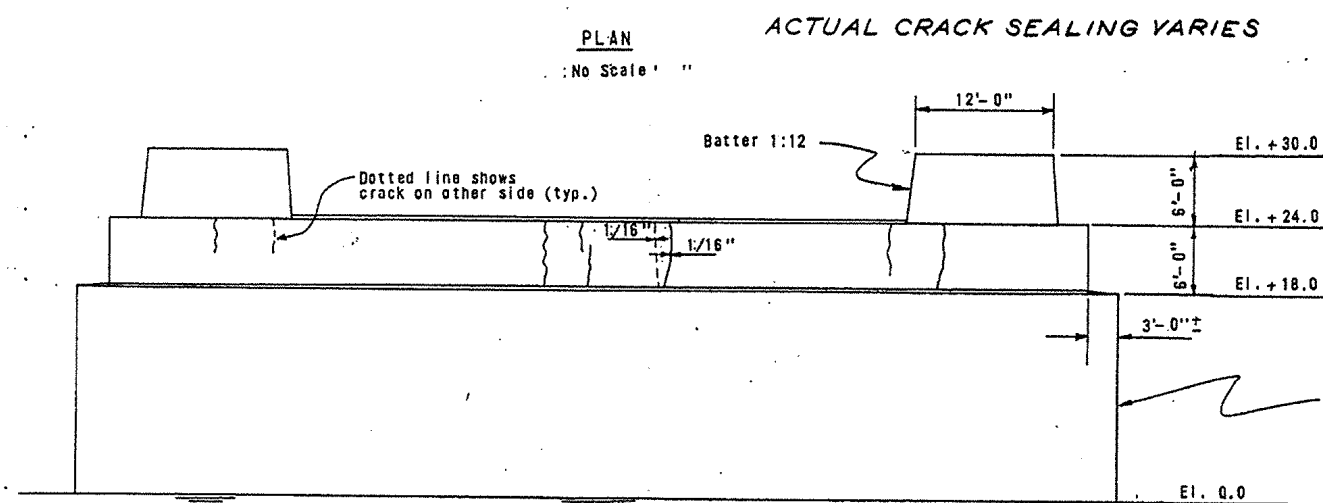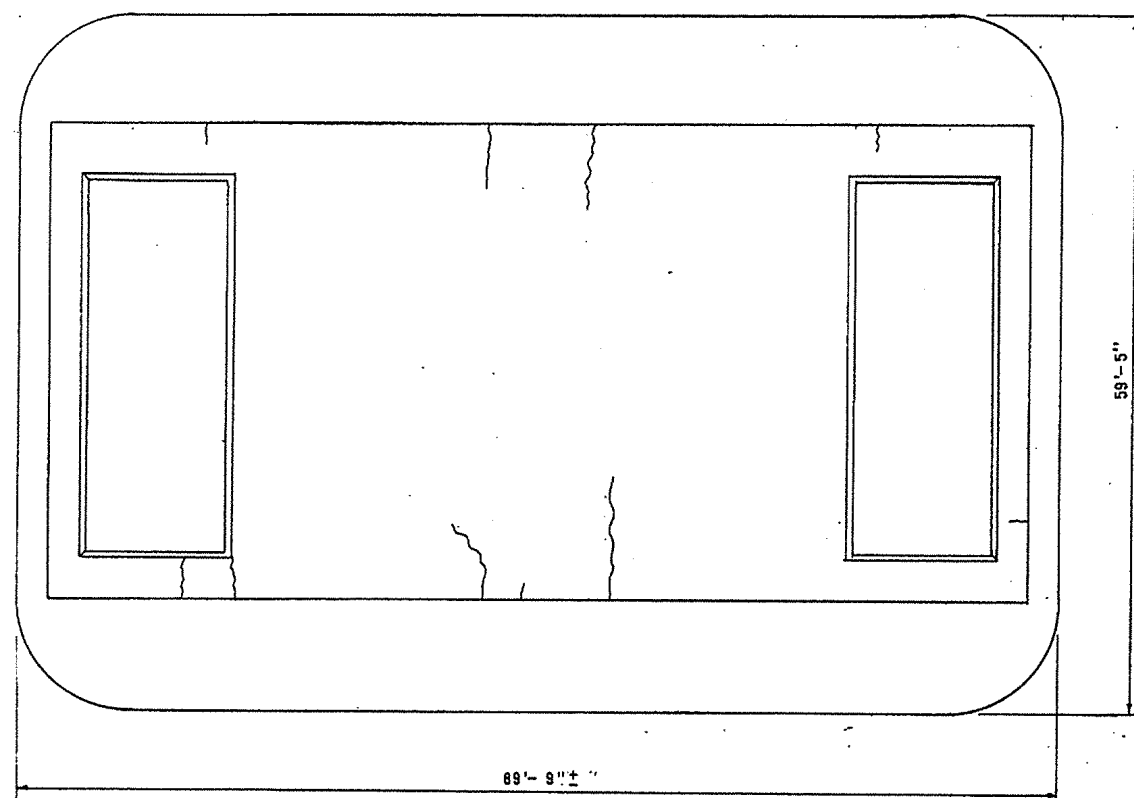

END ELEVATION
No Scale ' - '

- ## NOTES

1. Inject cracks where shown in plan and elevation views. Crack widths shown are approximate. Undimensioned cracks are less than 1/16" in width.
2. The locations of the cracks are taken from field inspection notes and may vary from that shown. The exact locations will be determined by the Engineer in the field.
3. Apply concrete sealant to all concrete surfaces between Elev. +18.0 and Elev. +30.0, including the tops of the pedestals.

Note: Elevations shown are based on S.F.O.B.B.
M.L.L.W. Datum.

AS
CORRE: S. WHIPPLE
CONTRACT N. 04-001734
DATE 8/92
FRS 4/8/34

DESIGN	By R. White	Checked S. Larsen
DETAILS	By D. Wu	Checked R. White
QUANTITIES	By K. Toy	Checked

State of
CALIFORNIA
DEPARTMENT OF TRANSPORTATION

STRUCTURES MAINT.

Richard W. White C16762
PROJECT ENGINEER REGISTERED CIVIL ENGINEER N

BRIDGE NO.
33-25
POST MILE
0.0/1.3

SAN FRANCISCO - OAKLAND BAY BRIDGE
SEISMIC RETROFIT
PIER E4

05 0138 04 2107

ORIGINAL SCALE IN INCHES
FOR REDUCED PLANS

CU 04 333
WO 001731

Disregard prints bearing earlier revision dates


REVISION RATES (PRELIMINARY STAGE ONLY)

SHEET	OF
6	14

DIST.	COUNTY	ROUTE	POST MILES—TOTAL PROJECT	SHEET NO.	TOTAL SHEETS
04	S.F. Ala	80	7.8/8.8, 0.0/1.3	8	15

R. W. White
 REGISTERED ENGINEER - CIVIL
 11-20-89
 PLANS APPROVAL DATE

REGISTERED PROFESSIONAL ENGINEER
 RICHARD W. WHITE
 No. C16762
 Exp. 6-30-93
 CIVIL
 STATE OF CALIFORNIA

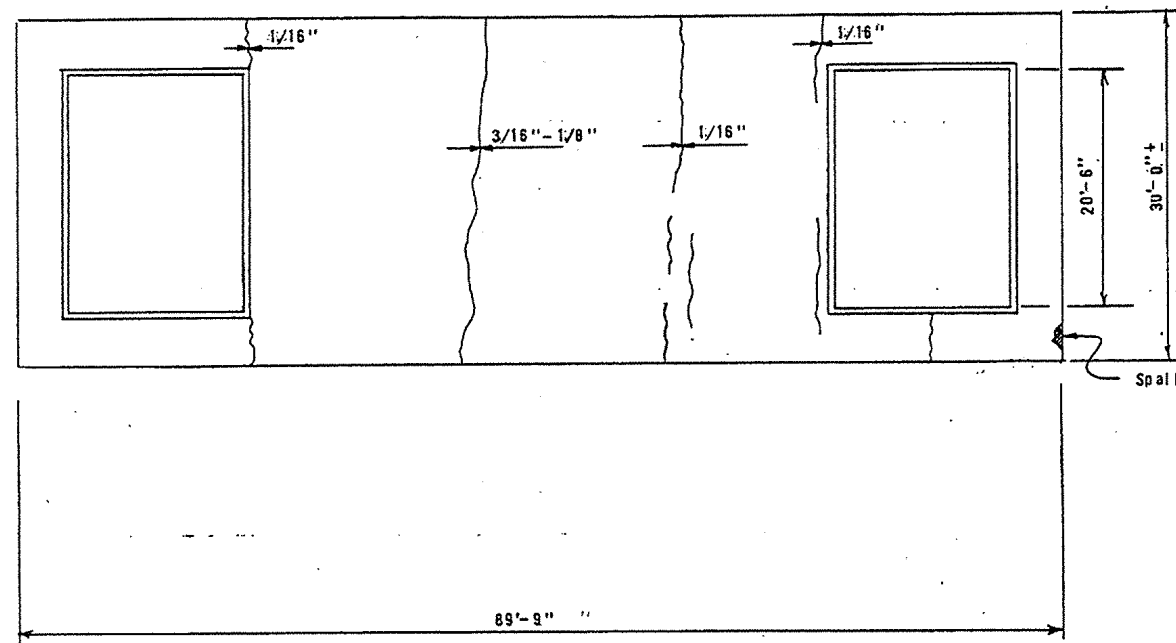


NOTES

- Inject cracks where shown in plan and elevation views. Crack widths shown are approximate. Undimensioned cracks are less than 1/16" width.
- The locations of the cracks are taken from field inspection notes and may vary from that shown. The exact locations will be determined by the Engineer in the field.
- Apply concrete sealant to all concrete surfaces between Elev. +20.0 and Elev. +30.0, including the tops of the pedestals.


Note: Elevations shown are based on S.F.O.B.B. M.L.L.W. Datum.

PLAN
No Scale

ACTUAL CRACK SEALING VARIES

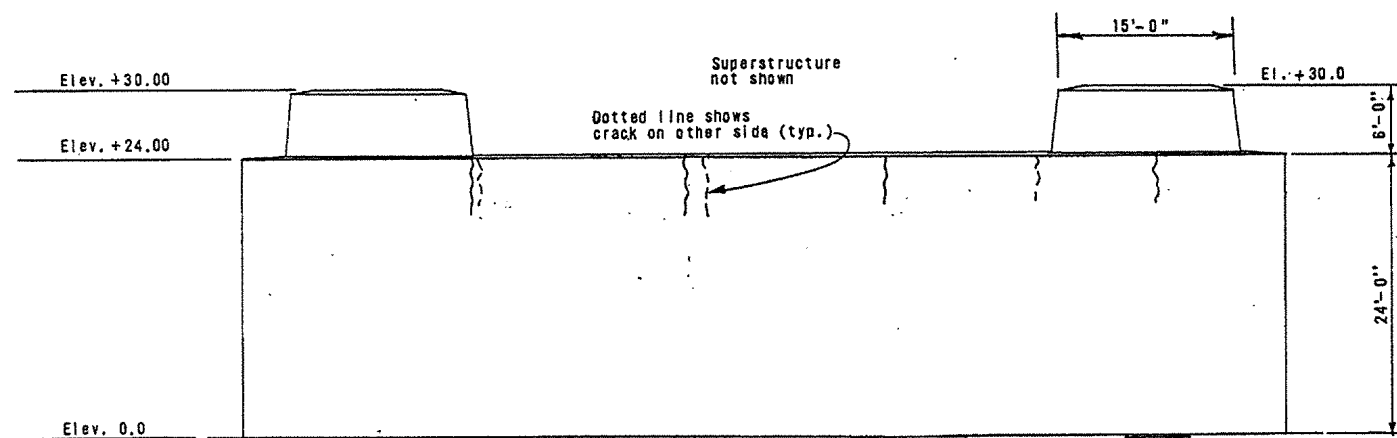

ELEVATION
No Scale

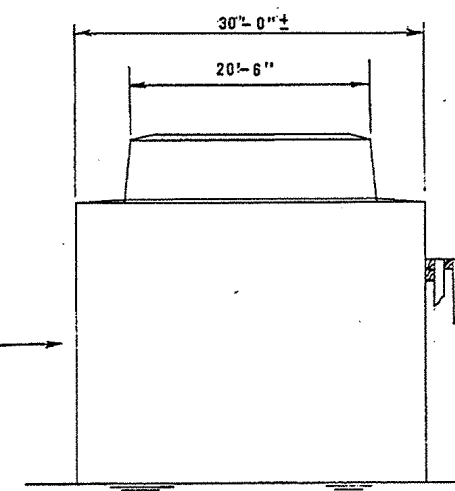

END ELEVATION
No Scale

AS
 CORRE: S. WHIPPLE
 CONTRACT NO. 04-001734
 DATE 8/92 FRS 4/8/94

Elev. +20.0
(Top of Timber Fender)

DESIGN	By	R. White	Checked	S. Larsen
DETAILS	By	D. Wu	Checked	R. White
QUANTITIES	By	W. Toy	Checked	

State of
CALIFORNIA
 DEPARTMENT OF TRANSPORTATION

STRUCTURES MAINT.
 Richard W. White C16762
 PROJECT ENGINEER REGISTERED CIVIL ENGINEER NO.

BRIDGE NO.
 33-25
 POST MILE
 0.0/1.3

SAN FRANCISCO - OAKLAND BAY BRIDGE
 SEISMIC RETROFIT
 PIER E5


ORIGINAL SCALE IN INCHES
FOR REDUCED PLANS

CU 04 333
 WO 001731

Discard prints bearing earlier revision dates

REVISION DATES (PRELIMINARY STAGE-ONLY)

SHEET 7 OF 14

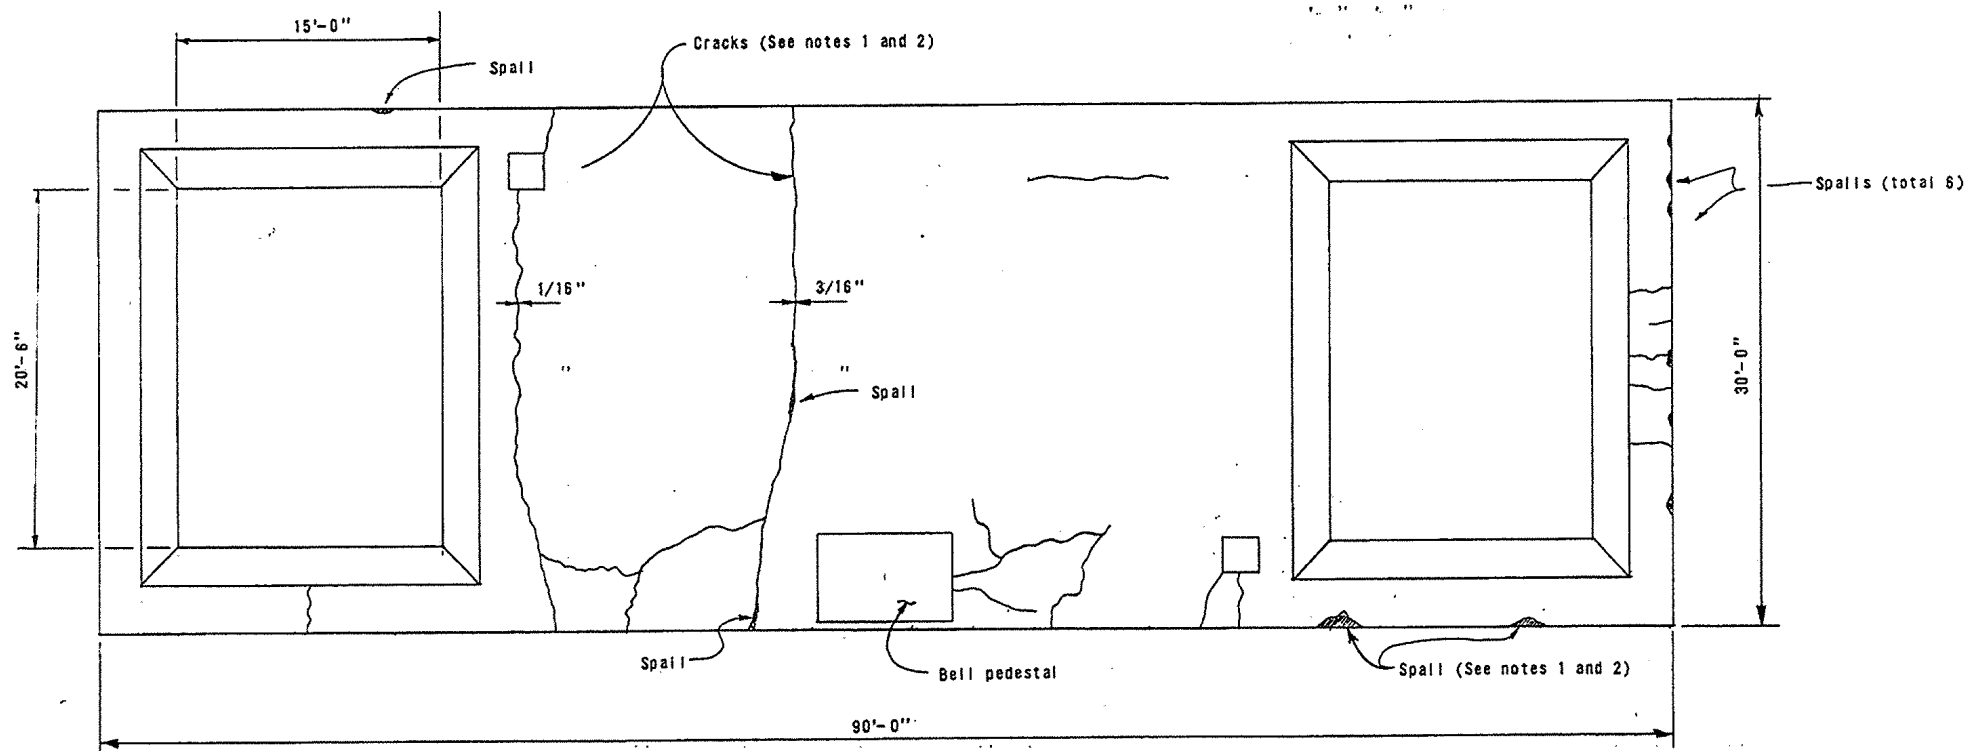

PLAN


No Scale

ACTUAL CRACK SEALING VARIES

NOTES

1. Inject cracks and patch spalls where shown in plan views. Crack widths shown are approximate. Undimensioned cracks are less than 1/16" in width.
2. The locations of cracks and spalls are taken from field inspection notes and may vary at certain locations. The exact locations will be determined by the Engineer in the field.
3. Drill two 2" \varnothing holes in both manhole cover plates at each pier.
4. Apply concrete sealant to all sides and top of the pier base and all sides and tops of the pedestals, above El. +4.0.
5. For cracks and spalls in piers E7 and E8 see E7, E8, E11, E12 and E13 sheet. Other details of these piers are similar to those shown for pier E6.

Note: Elevations shown are based on S.F.O.B.B. M.L.L.W. Datum.

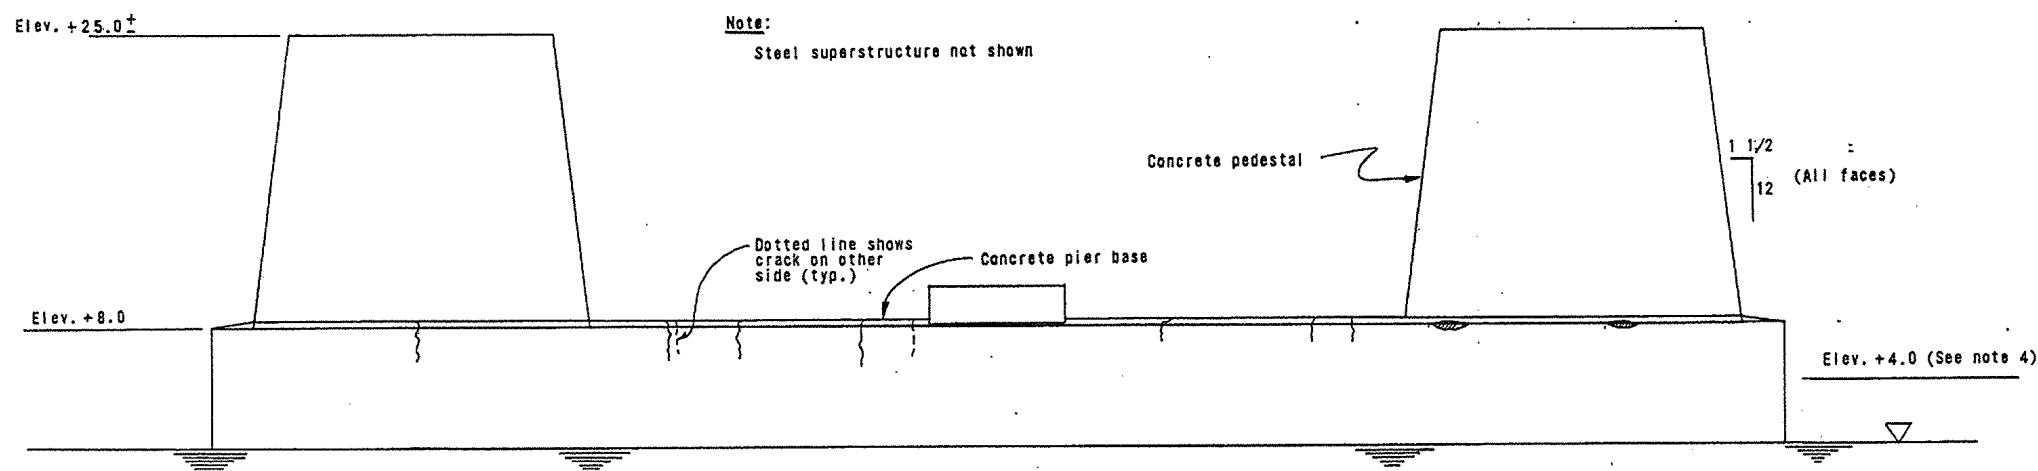

ELEVATION

No Scale

AS

CORRE: S. WHIPPLE

CONTRACT: 04-001734

DATE: 8/92 FRS 4/8/94

DESIGN	By R. White	Checked S. Larsen
DETAILS	By D. Wu	Checked R. White
QUANTITIES	By W. Toy	Checked

State of
CALIFORNIA
DEPARTMENT OF TRANSPORTATION

STRUCTURES MAINT.

Richard W. White C16762
PROJECT ENGINEER REGISTERED CIVIL ENGINEER NO.

BRIDGE NO.
33-25
POST MILE
0.0/1.3

SAN FRANCISCO - OAKLAND BAY BRIDGE
SEISMIC RETROFIT


PIER E6

ORIGINAL SCALE IN INCHES
FOR REDUCED PLANS

CU 04 333
WO 001731

Disregard prints bearing earlier revision dates



REVISION DATES (PRELIMINARY STAGE ONLY)
7/7/89
SHEET 8 OF 14

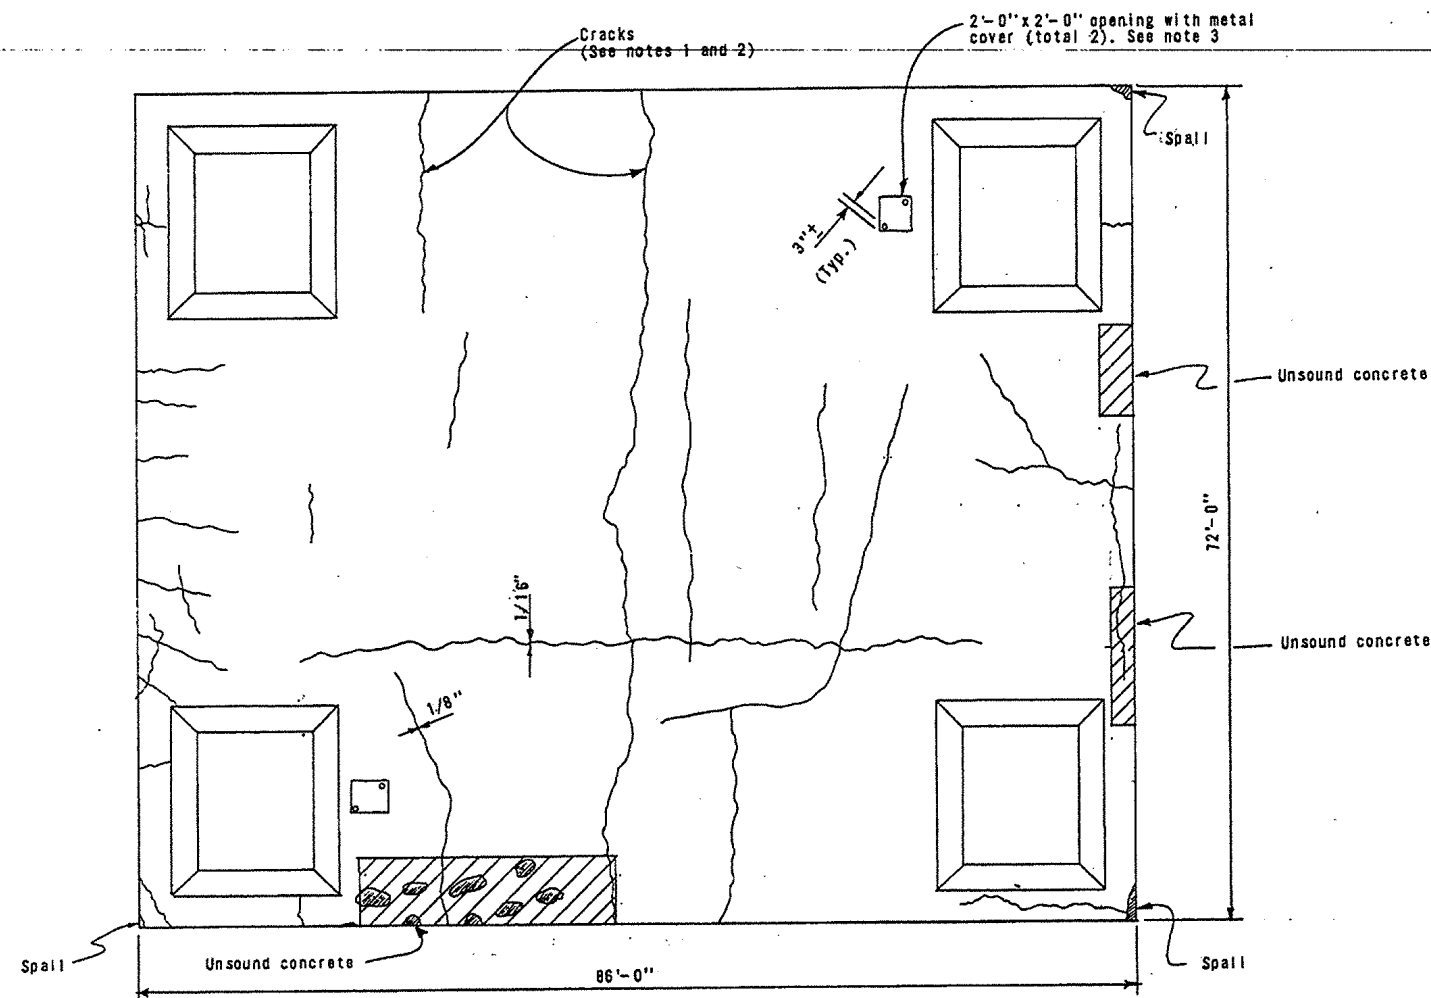

Note: Elevations shown are based on S.F.O.B.B. M.L.L.W. Datum.

NOTES

1. Inject cracks and patch spalls where shown in plan views. Crack widths shown are approximate. Undimensioned cracks are less than 1/16" in width.
2. The locations of cracks and spalls are taken from field inspection notes and may vary at certain locations. The exact locations will be determined by the Engineer in the field.
3. Drill two 2" \varnothing holes in both manhole cover plates.
4. Apply concrete sealant to all sides and top of the pier base and all sides and tops of the pedestals above El. +4.0.

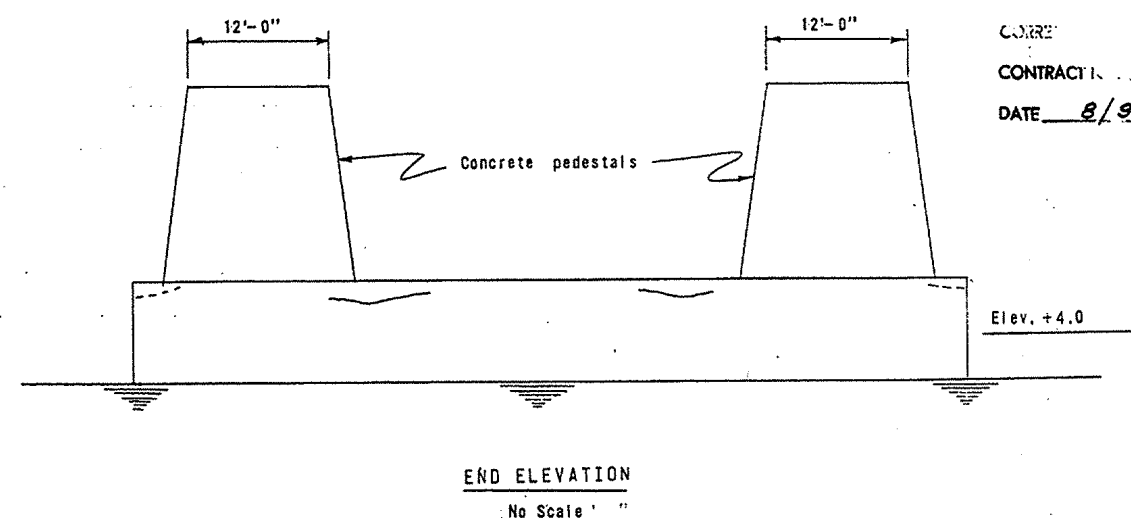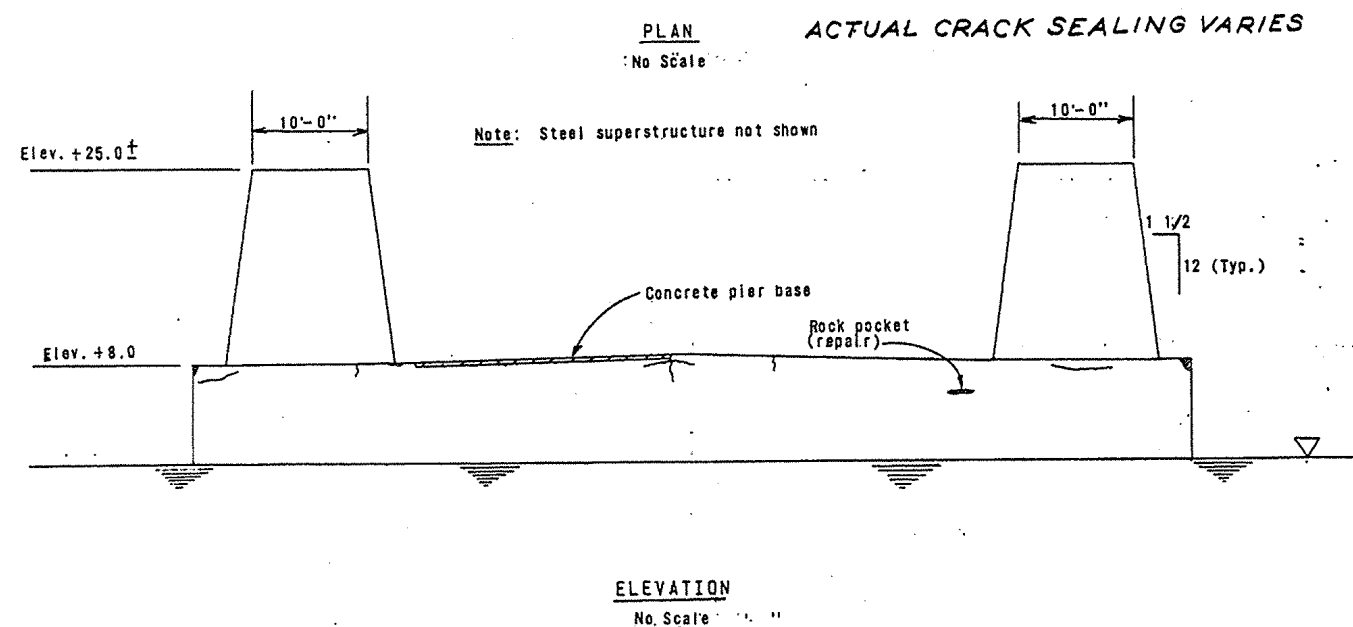

CORRE S. WHIPPLE
 CONTRACT 04-001734
 DATE 8/92 FR 5 4/8/94

DESIGN	By R. White	Checked S. Larsen
DETAILS	By D. Wu	Checked R. White
QUANTITIES	By W. Toy	Checked

State of
CALIFORNIA
 DEPARTMENT OF TRANSPORTATION

STRUCTURES MAINT.

Richard W. White C16762
 PROJECT ENGINEER REGISTERED CIVIL ENGINEER NO.

BRIDGE NO.
 33-25
 POST MILE
 00/1.3

SAN FRANCISCO - OAKLAND BAY BRIDGE
 SEISMIC RETROFIT

PIER E9

ORIGINAL SCALE IN INCHES
FOR REDUCED PLANS

0 1 2 3

CU 04 333
 WO 001731


Disregard prints bearing earlier revision dates

2/7/99

REVISION DATES (PRELIMINARY STAGE ONLY)

SHEET
 9 OF 14

2

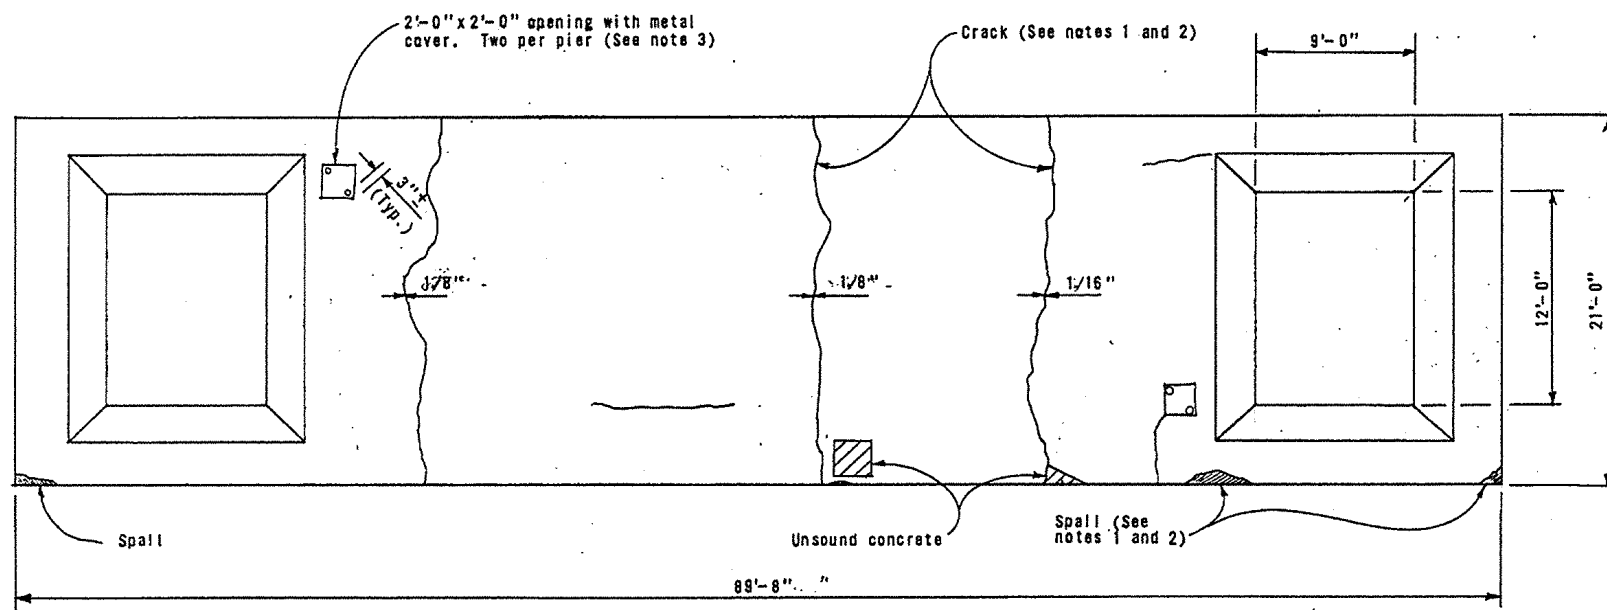


PLAN
No Scale

ACTUAL CRACK SEALING VARIES

NOTES

1. Inject cracks and patch spalls where shown in plan views. Crack widths shown are approximate. Undimensioned cracks are less than 1/16" in width.
2. The locations of cracks and spalls are taken from field inspection notes and may vary at certain locations. The exact locations will be determined by the Engineer in the field.
3. Drill Two 2" Ø holes in both manhole cover plates at each pier.
4. Apply concrete sealant to all sides and top of the pier base and all sides and tops of the pedestal above El. +4.0.
5. For cracks and spalls on piers E11 thru E16 see piers E7, E8, E11, E12 and E13 and piers E14, E15, E16, E18 and E19 sheets. Other details of these piers are similar to those shown for pier E10.

Note:
Steel superstructure not shown.

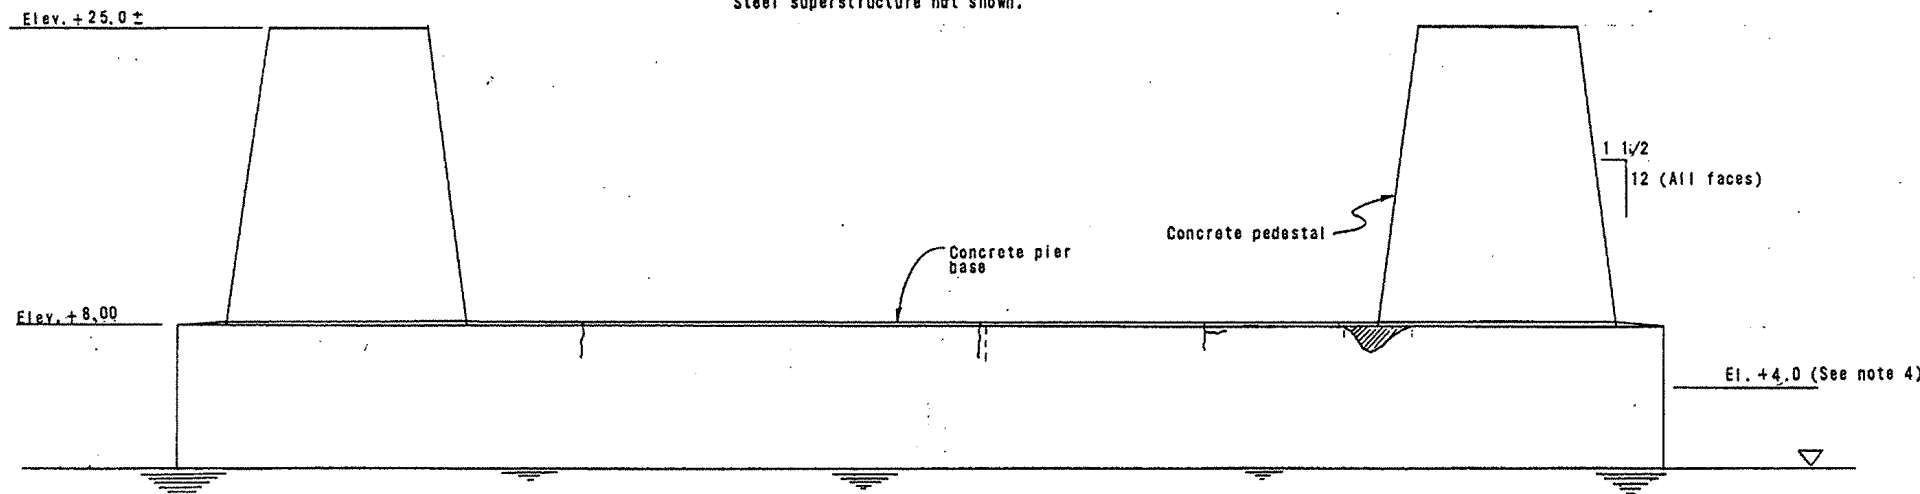

ELEVATION
No Scale


Note: Elevations shown are based on S.F.O.B. Datum.
M.L.L.W. Datum.

AS

CORRE S. WHIPPLE

CONTRACT 04-001734

DATE 8/92 FRS 4/8/94

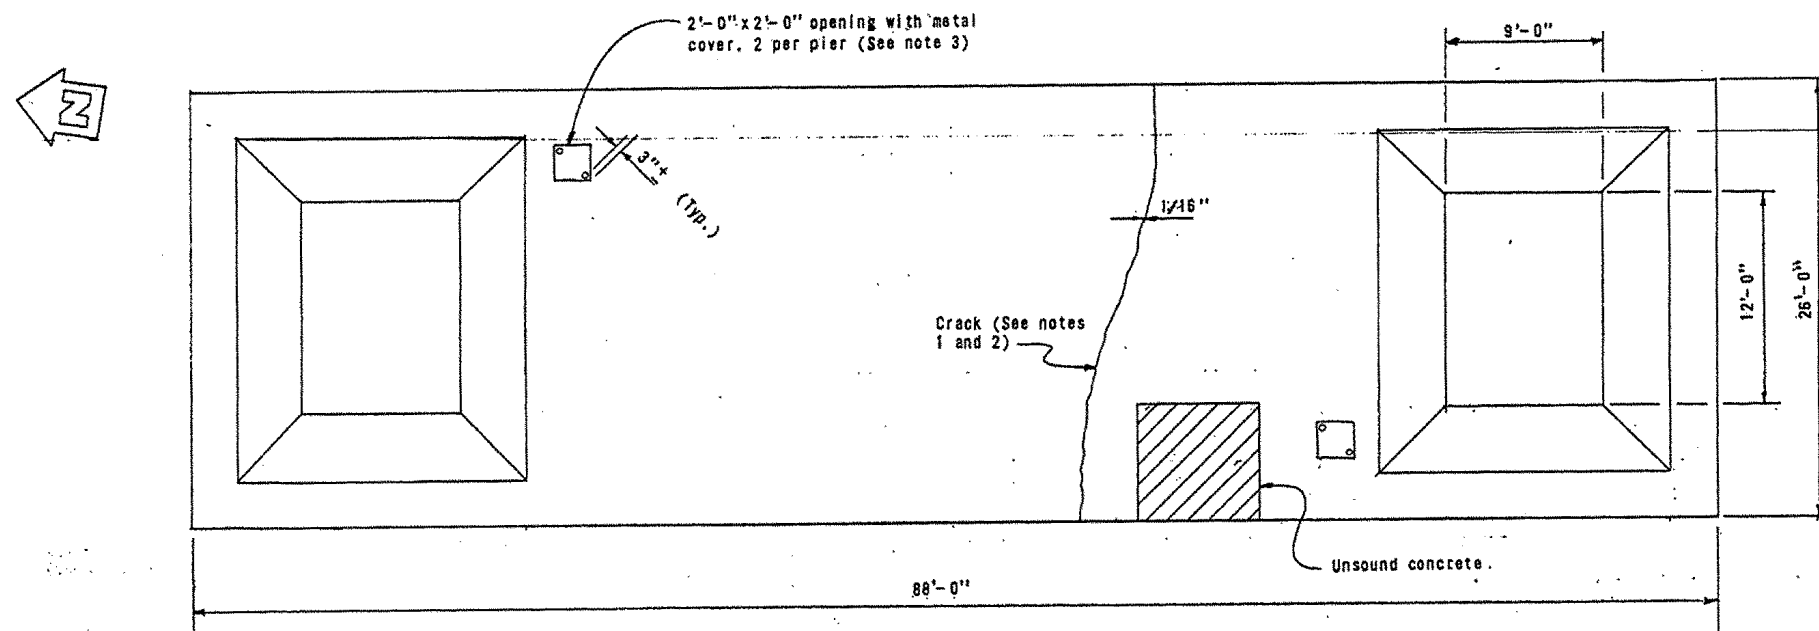

88'-0"

Unsound concrete.

PLAN
No Scale

ACTUAL CRACK SEALING VARIES

NOTES

1. Inject cracks and patch spalls where shown in plan views. Crack widths shown are approximate. Undimensioned cracks are less than 1/16" in width.
2. The locations of cracks and spalls are taken from field inspection notes and may vary at certain locations. The exact locations will be determined by the Engineer in the field.
3. Drill two 2" \varnothing holes in both manhole cover plates at each pier.
4. Apply concrete sealant to all sides and top of the pier base and all sides and tops of the pedestals, above El. +4.0.

Note: Elevations shown are based on S.F.O.B.S. M.L.L.W. Datum.

Elev. A
(Varies - see Table)

Note
Steel superstructure not shown.

PIER PEDESTAL ELEVATIONS	
Pier No.	Elev. A
E17	+61.24
E18	+53.26
E19	+45.27
E20	+37.26
E21	+29.28
E22	+21.25

1/12

1/12 (Typ. all faces)

Dotted line shows crack on other side (typ.)

Unsound concrete

Elev. +8.0

El. +4.0 (See note 4)

ELEVATION
No Scale

AS

CORREL. S. WHIPPLE

CONTRACT NO. 04-001734

DATE 8/92 FRS 4/8/94

DESIGN	By R. White	Checked S. Larsen
DETAILS	By D. Wu	Checked R. White
QUANTITIES	By W. Toy	Checked

State of
CALIFORNIA
 DEPARTMENT OF TRANSPORTATION

STRUCTURES MAINT.

Richard W. White C16762
 PROJECT ENGINEER REGISTERED CIVIL ENGINEER NO.

BRIDGE NO.
 33-25
 POST MILE
 00/1.3


SAN FRANCISCO - OAKLAND BAY BRIDGE
 SEISMIC RETROFIT
 PIER E17

CU 04 333
 WO 001731


Disregard prints bearing earlier revision dates

REVISION DATES (PRELIMINARY STAGE ONLY)


2/2/94
 SHEET 11 OF 14

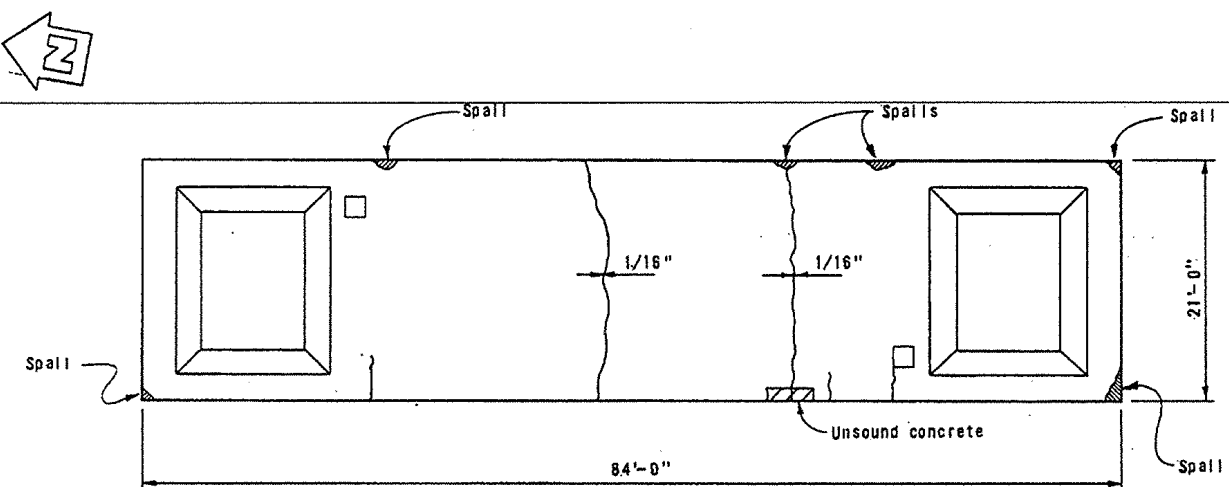


PLAN - PIER E14
No Scale

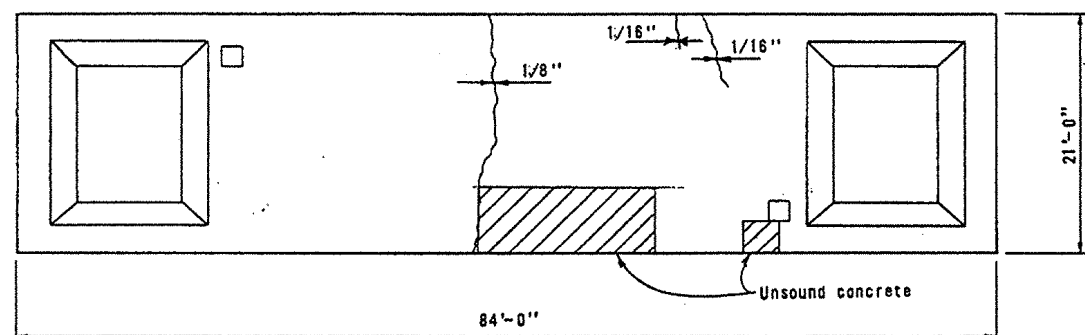


PLAN - PIER E15
No Scale

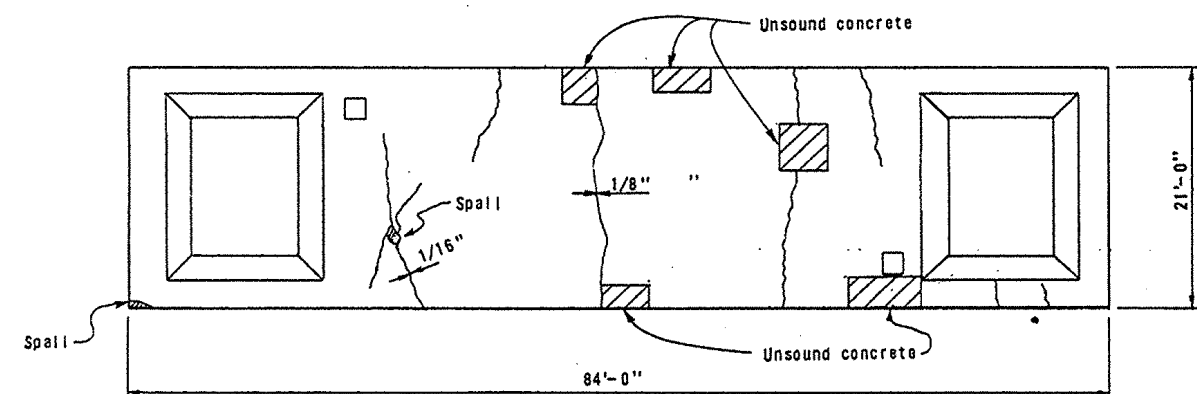

PLAN - PIER E16
No Scale

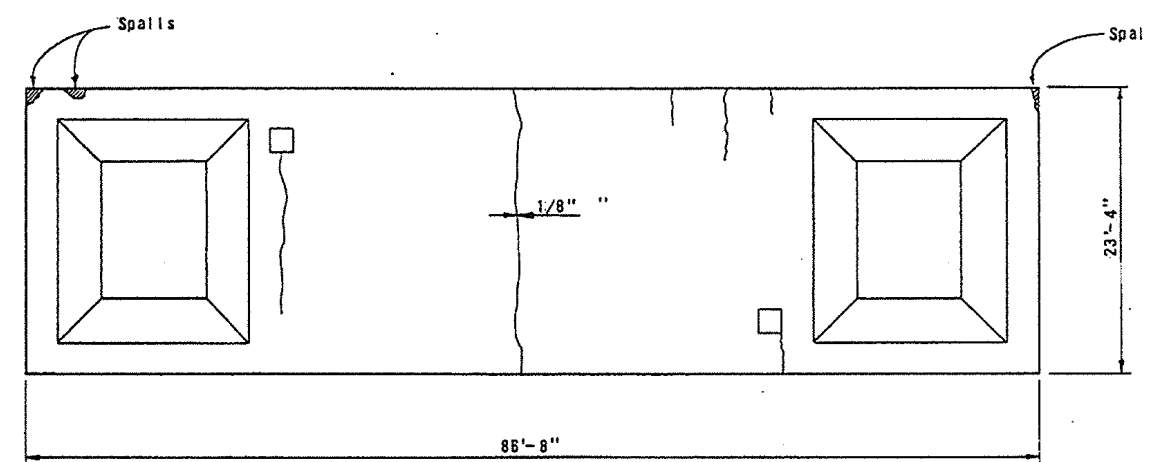

PLAN - PIER E18
No Scale

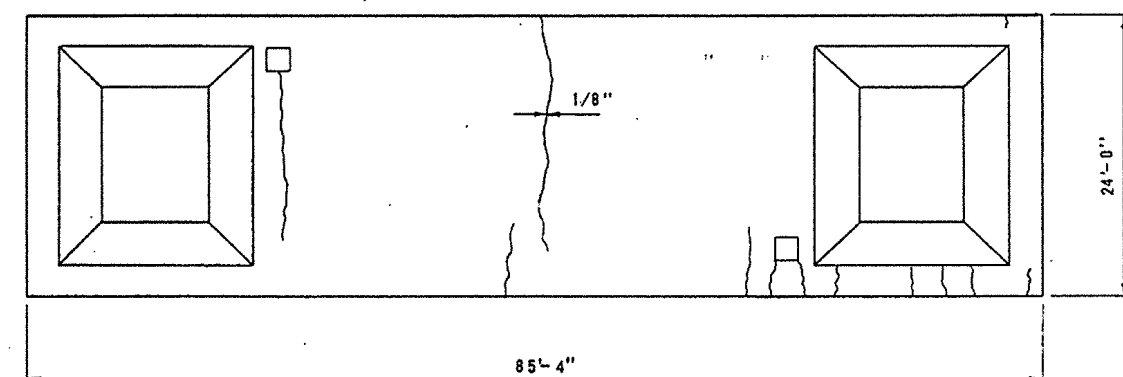

PLAN - PIER E19
No Scale

ACTUAL CRACK SEALING VARIES

AS
CORRECTED S. WHIPPLE
CONTRACT 04-001734
DATE 8/92 FRS 4/8/94

Note: Elevations shown are based on S.F.O.B.B. M.L.L.W. datum.

NOTES

- For additional details and notes for piers E14, E15 and E16, see Pier E10. For piers E18 and E19, see Pier E17.

DESIGN	By	D. Wu	Checked	R. W. White
DETAILS	By	J. Wong	Checked	R. W. White
QUANTITIES	By	W. Toy	Checked	

State of
CALIFORNIA
DEPARTMENT OF TRANSPORTATION

DIVISION OF STRUCTURES
STRUCTURE MAINT.
Richard W. White C16762
PROJECT ENGINEER REGISTERED CIVIL ENGINEER NO.

BRIDGE NO.
33-25
POST MILE
0.0/1.3

SAN FRANCISCO - OAKLAND BAY BRIDGE
SEISMIC RETROFIT
PIERS E14, E15, E16, E18 AND E19

ORIGINAL SCALE IN INCHES
FOR REDUCED PLANS

0 1 2 3


CU 04 333
WO 001731

Disregard prints bearing earlier revision dates

REVISION DATES (PRELIMINARY STAGE ONLY)

2/4/94

SHEET OF
13 14

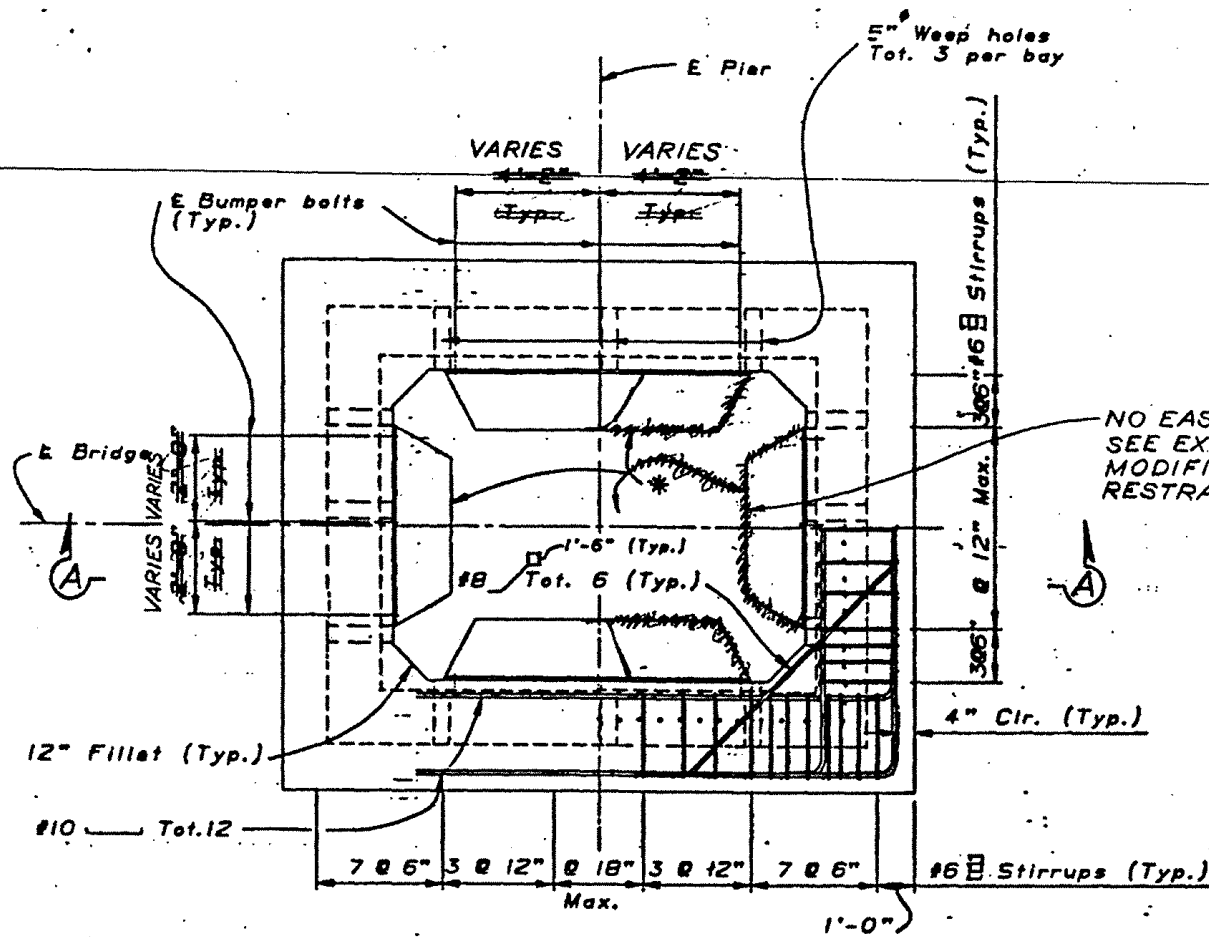


PLAN PIERS E-18 TO E-22

3/8"=1'-0"

NORTH


NO EAST BUMPER ADDED -
SEE EXTRA SHEET FOR
MODIFICATIONS OF EXISTING
RESTRAINERS.

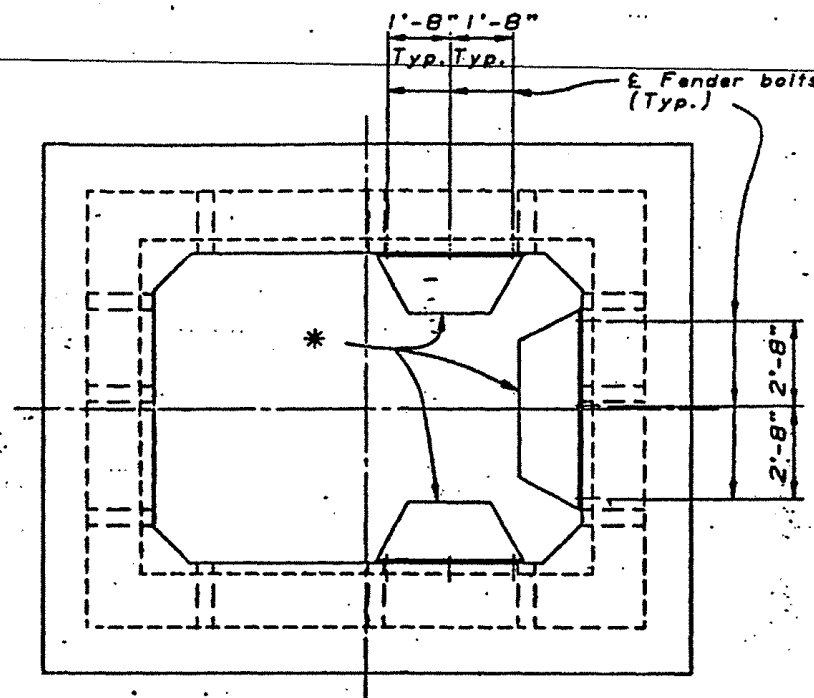

PLAN PIER E-17

3/8"=1'-0"

04-SF, Alameda 80, 7.8/8.8, 0.0/1.3
 04-001734 (505) City & Co of SF &
 Alameda Co at var loc on the
 SF-Oakland Br-(Reinforce piers)

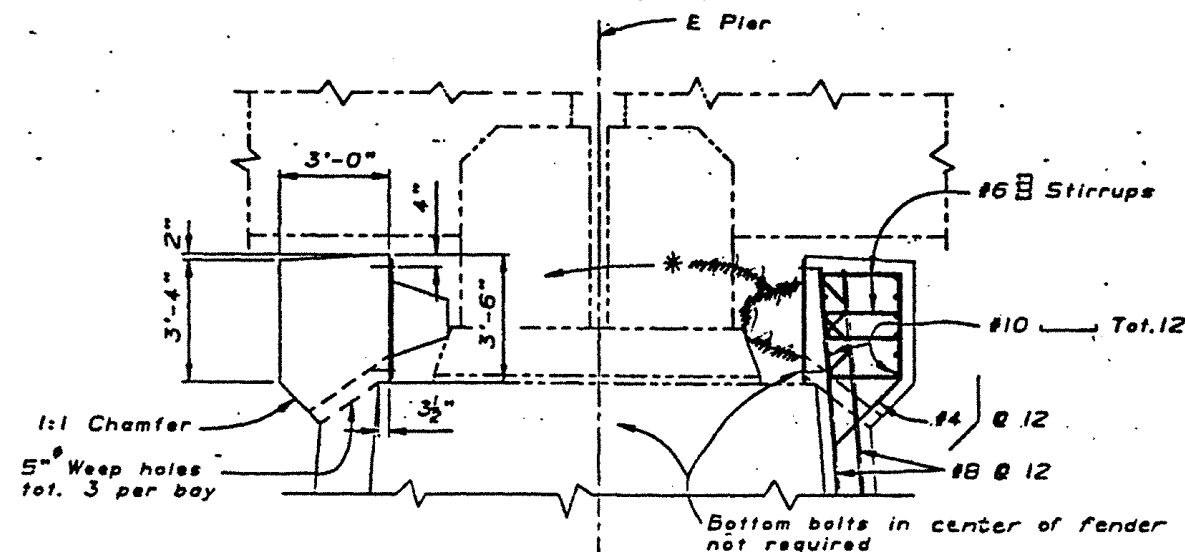

SECTION A-A

3/8"=1'-0"

NOTES:

Remove existing earthquake restrainers.

Indicates existing structure.

* Indicates location of Uniroyal ~~300~~ Fenders.

Pier E-17 is similar to other
piers except as noted.

SIZE VARIES
TO FIT

REINFORCED CONCRETE: $f_y = 60,000$ psi
 $f'_c = 3,250$ psi
 $n = 9$

NOTE:
THE CONTRACTOR SHALL VERIFY ALL
CONTROLLING FIELD DIMENSIONS
BEFORE ORDERING OR FABRICATING
ANY MATERIAL.

ADDED SHEAR BLOCKS TO TOP OF
PEDESTALS E17 TO E22. SEE
ADDED SHEET FOR MODIFICATIONS
OF THIS SHEET.

AS BUILT

CORRECTED BY S. WHIPPLE

CONTRACT NO. 04-001734

DATE 8/92
FRS 4/8/94

CONTRACT CHANGE ORDER NO.
SHEET ____ OF ____


DESIGN	By <i>Manuel Camacho</i> 3-90	CHECKED <i>Manuel Camacho</i> 3-90
DETAILS	By <i>Manuel Camacho</i> 3-90	CHECKED <i>Manuel Camacho</i> 3-90
QUANTITIES	By <i>Manuel Camacho</i> 3-90	CHECKED <i>Manuel Camacho</i> 3-90

STATE OF
CALIFORNIA
DEPARTMENT OF TRANSPORTATION

DIVISION OF STRUCTURES
STRUCTURE MAINTENANCE


BRIDGE NO.	33-25
POST MILE	0.0/1.3

S.F.O.B.B. SEISMIC RETROFIT
DETAILS FOR PIERS E-10 TO E-22

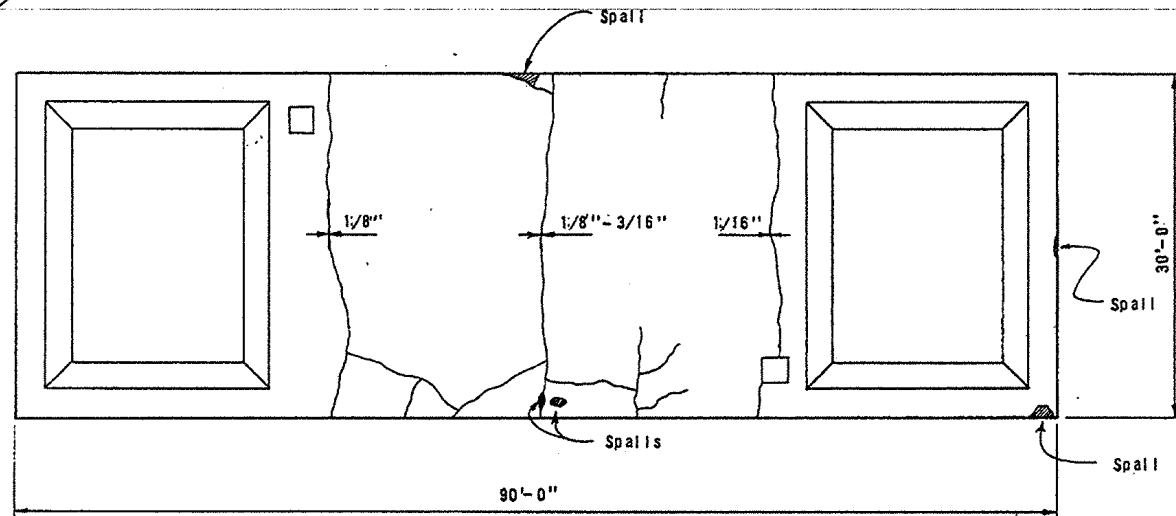


PLAN - PIER E7
 No Scale

ACTUAL CRACK SEALING VARIES

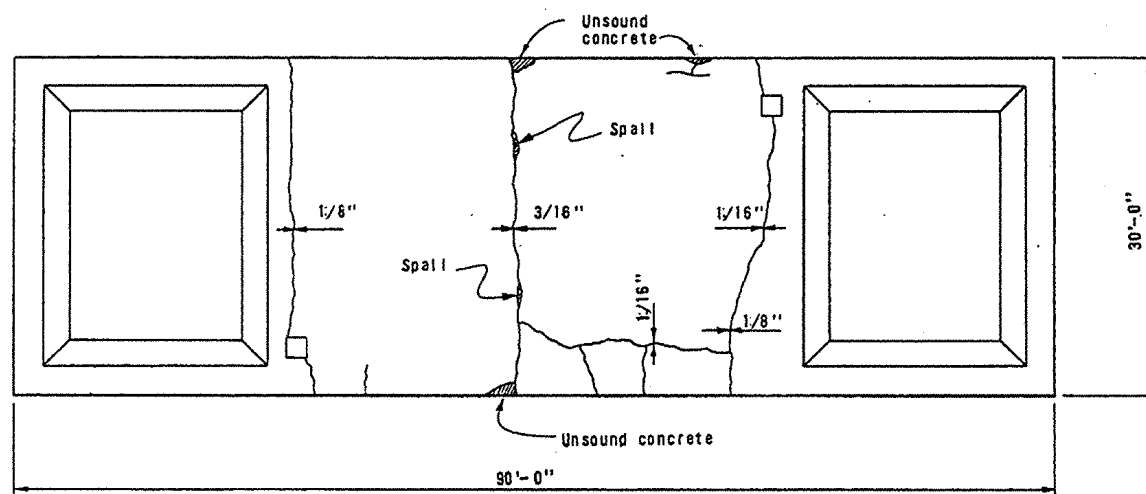


PLAN - PIER E8
 No Scale

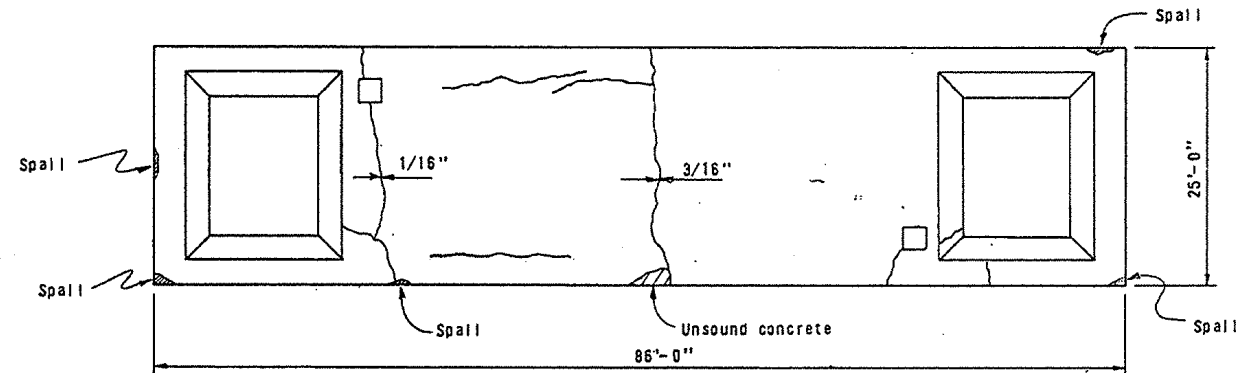


PLAN - PIER E11
 No Scale

CORRE. S. WHIPPLE
 CONTRACT 04-001734
 DATE 8/92
 FRS 4/8/94

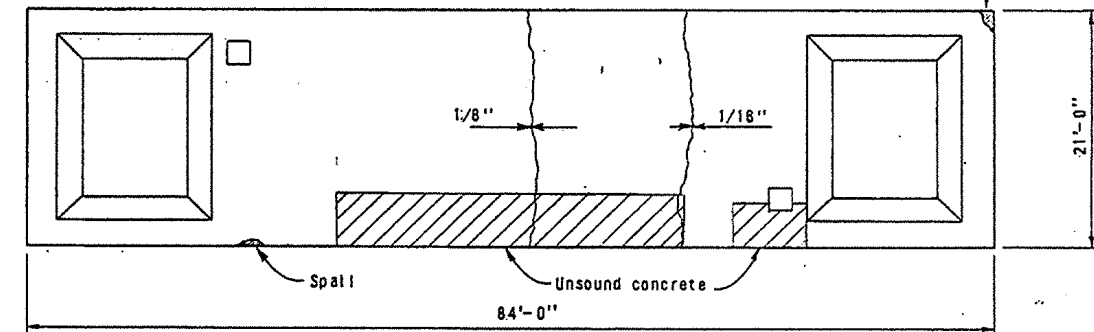

PLAN - PIER E12
 No Scale

Note: Elevations shown are based on S.F.O.B.B.
 M.L.L.W. Datum.

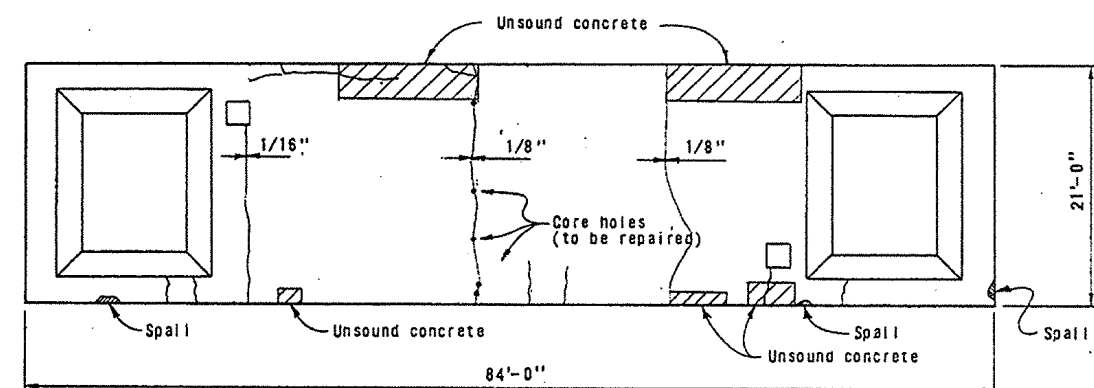

PLAN - PIER E13
 No Scale

NOTES

- For additional details and notes for piers E7 and E8, see Pier E6. For piers E11, E12 and E13, see Pier E10.


DESIGN	By D. Wu	Checked R. White
DETAILS	By J. Wong	Checked R. White
QUANTITIES	By W. Toy	Checked

State of
 CALIFORNIA
 DEPARTMENT OF TRANSPORTATION



DIVISION OF STRUCTURES
 STRUCTURE MAINT.
 Richard W. White C16762
 PROJECT ENGINEER REGISTERED CIVIL ENGINEER NO.

BRIDGE NO.
 33-25
 POST MILE
 00/13





SAN FRANCISCO - OAKLAND BAY BRIDGE
 SEISMIC RETROFIT
 PIERS E7, E8, E11, E12 AND E13

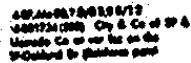

Note: Elastomeric pads are fabric reinforced laminated elastomeric pads, per Section 51-1.12M(1) of the Standard Specifications.

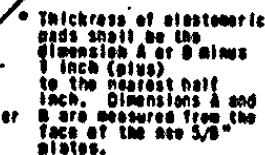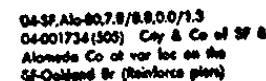

PART SECTION AT PIER
Typical for four penetrals at each pier
Scale: 3/4" = 1'-0"

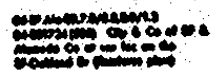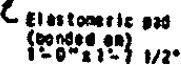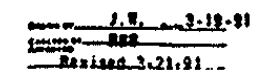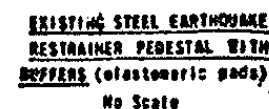

Note: 2" Clearance
min. between jacket
notch and reinforcing
steel.

NO AS BUILT CHANGES

S.F.O.B.B. SEISMIC RETROFIT
DETAILS FOR PIERS E-17 TO E-22

DISREGARD PRINTS BEARING
EARLIER REVISION DATES

REVISION DATES (DD, MM, YYY) 01/01/00 01/01/00 01/01/00

1-11	1-12
110	111